


Barton

KANSAS

SECTION 20 TOWNSHIP 19 RANGE 13 W

WELL NO. #2 Kirkman

COMPANY Frontier Oil

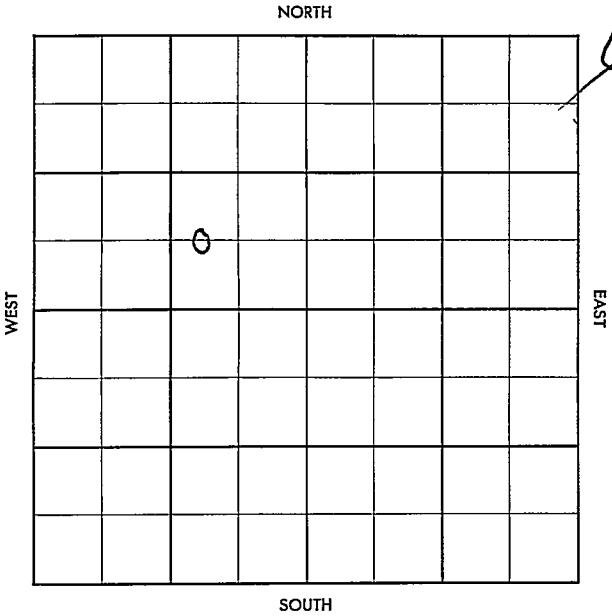

Barton

KANSAS

SEC.	TWP.	R.
20	19	13W

WELL NO.

#2 Kirkman

FARM

COMPANY

Frontier Oil

CONTRACTOR

K & K


Gt. Bend Townsite

_____ Ft. from N. Line

_____ Ft. from S. Line

_____ Ft. from E. Line

_____ Ft. from W. Line

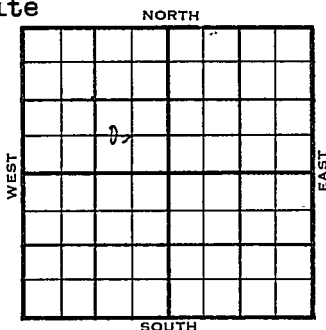C W $\frac{1}{2}$ SE NW


1956	ELEVATION	REPORT
	1857	
1-18	Comm. 1-15-56 8" @ 700 WOC	
3/28	Comm 1-15-56 Anh 765 H 3073 L 3181 A 3433 TD 3460 8" @ 700 DST 3334-48 open 1 hr rec 50' GIP 10' gcm 0/20" DST 3435-45 open 1 hr rec 30' mud 150/20" DST 3445-60 open 1 hr 60' gas rec 40' o & gcm 640/20" 5 1/2" @ 3459 CO to 3460 32/3446-54 500 A S/1 boph 8 hr dec to 0 in 8 hr SP 3450 perf 3450-54 1000 A S/20 boph 4 hr Comp 78 BOPD 14% wtr	

COMPLETED

County Barton Elev. _____
 Sec. 20 Twp. 19 Rge. 13W
 Company Frontier Oil
 Farm Name Kirkman No. 2

TOPS	DEPTH	LOG	DATUM	Loc. in Sec.
Anh.				C W $\frac{1}{2}$ SE NW
TP.				
H.				
Tr.				
Dg.				
BL.				
L.				
K.C.				Geol. _____
B.K.C.				Contr. _____
Ce.				K & K
C.				
M.				Pool _____
M.				Gt. Bend Twnsite
K.				
Mz.				
Mq.				
V.				
S.				
S.				
A.				
R.				
PE.				
G.				
T.D.				

Date Comm. 1-15-56
8" @ 700 WOC

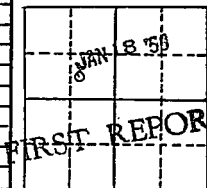

County Barton Elev. 1857
 Sec. 20 Twp. 19 Rge. 13W
 Company Frontier Oil
 Farm Name Kirkman No. 2

TOPS	DEPTH	LOG	DATUM
Anh.	765		
Tp.			
H.	3073		
Tr.			
Dg.			
BL.			
L.	3181		1324
K.C.			
B.K.C.			
Ce.			
C.			
M.			
M.			
K.			
Mz.			
Ma.			
V.			
S.			
S.			
A.	3433		1576
R.			
PE.			
G.			
T.D.	3460		

Loc. in Sec. C W $\frac{1}{2}$ SE NW

Geol. _____

Contr. _____

K & K

Pool _____

Gt. Bend Twst _____

MAR 28 '58

COMPLETE

Date Comm. 1-15-56

8" @ 700 DST 3334-48 open 1 hr.

rec. 50' GEF 10' gcm 0/20"

DST 3435-45 open 1 hr. rec. 30' mud

150/20" DST 3445-60 open 1 hr.

60' gas rec. 40' o & gcm 640/20"

51" @ 3459 CO to 3460 32/ 3446-54

500 A S/ 1 boph 8 hr. dec. to 0 in

8 hr. SP 3450 perf. 3450-54 1000 A

OVER

S/ 20 boph 4 hr. Comp. 78 bopd 114% wtr.

M. MC.

APR 6 1956