

file

Office of County Engineer, Ness County


GEORGE PROSE, County Engineer

NESS CITY, KANSAS

9 - 30 - 64

Moore C #2

150 FT . west of C - NW - SW - 30 - 19 - 21 - Ness County, Kansas.

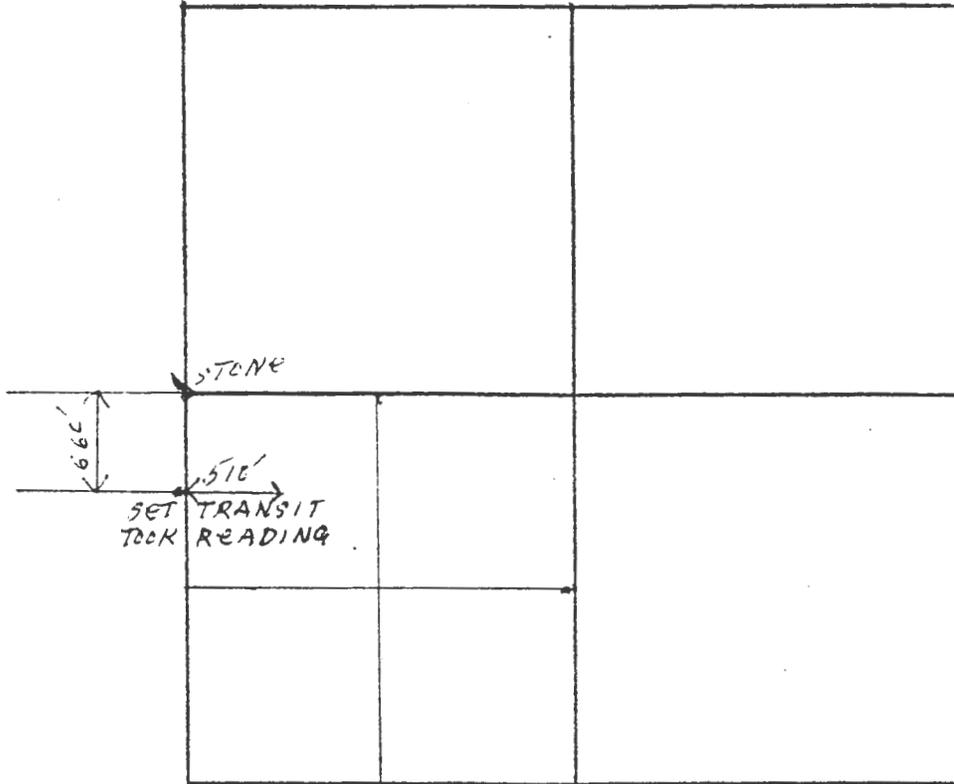

Surveyed and Plotted by
George W. Prose, County Engineer
Ness County, Kansas

George W. Prose
George W. Prose