

LOC & WELL NO.: REIN "A" 4

LOCATION: 660' FNL-510' FWL Sec 27-19-21 County: Ness

Elevation -- G.L.: 2308

R.K.B.: 2316

Date Completed: 8-19-66

Initial Potential: 132 bot + chs-24

Producing Formation: Mississippi

Top: 4430 (21/4)

Current Production: 5 + 24'

Accumulated Production: 114,976 bot + 452,576 bw

Casing: 8 5/8" @ 509' w/ 75sx

4 1/2" @ 41-27 w/ 150s

Total Depth: 4468

PBTD: 4455'

DV Tool:

WORKOVER RECORD: Completion Perforated 4438-44

Az w/ 250 gal 7 1/2% IP 132 bot

11-29-66 Camp AZ10 w/ 500 gal Dowell 5% - 46 bot
BWO: 44 + 7 AWO: 54 + 33

12-28-67 Repair casing leak @ 752' w/ 300sx
AWO: 0 + 180 AWO: 26 + 23

1-16-68 Dump ACID 150 gal + 10 gal 4.6% + 47
BWO: 29 + 13 AWO: 57 + 46

10-31-70 Dump ACID 250 gal XLF + 65 bot
BWO: 27 + 74 AWO: 29 + 77

10-5-71 Dump ACID 500 gal 15% + 55 bot
BWO: 21 + 70 AWO: 23 + 73

1977 Dump ACID 250 gal 1100-202 + 40 bot
BWO: 9 + 92 AWO: 19 + 118

4438-44


9-28-78 Chemical Squeeze 55 gal Visc 957

Best Scanned Copy

4 1/2" @
4467
w/ 150sx

TL 4468

4438-44

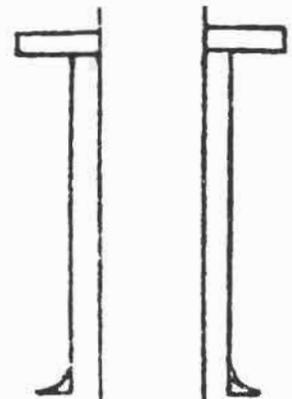

8 5/8" @
509'
4 1/2" @ 275'

1070
4455'