


of Cities Service Oil Company, do hereby certify

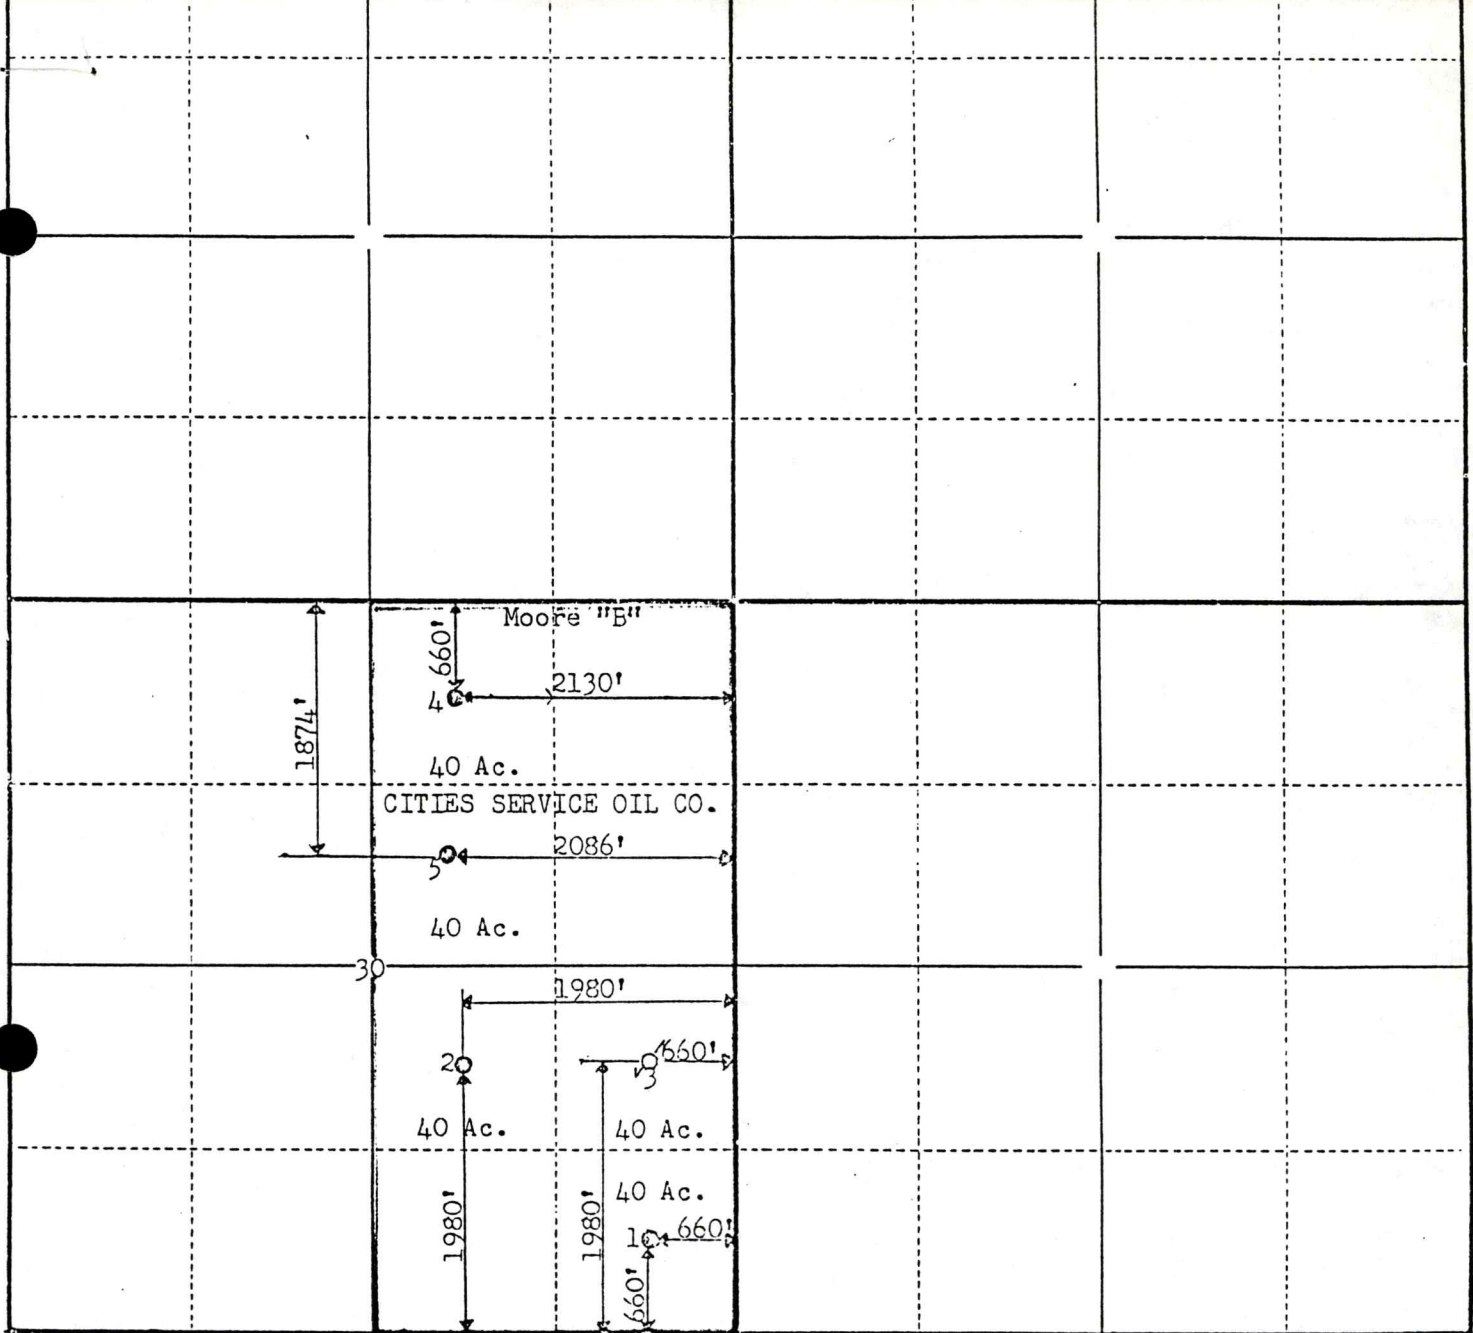

STATE OF KANSAS,
COUNTY OF ~~SEDGWICK~~ BARTON

I, O. C. Atkinson, Division Engineer
of Cities Service Oil Company, do hereby certify
that the above locations, feet measurements and areas are true and correct to the best of my knowledge.

O. C. Atkinson

Subscribed and sworn to before me this 14th day of July, 19 65

My commission expires December 6, 1966

C M McFarland
NOTARY PUBLIC
C. M. McFarland

