


Section 21 Township 19 Range 11W

Well No. #2 J. B. Birzer

Company W. L. Hartman

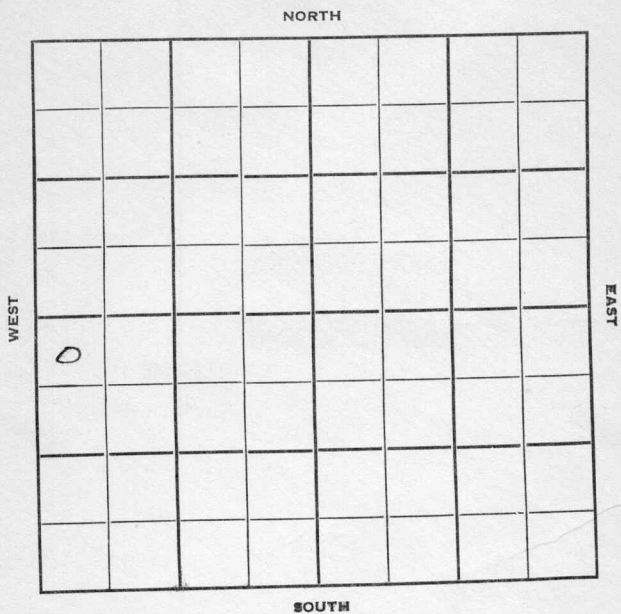

Sec. 21 Twp. 19 R. 11W

Well No. #2 J.B. Birzer Farm

W.L. Hartman Company

Garvey Contractor


330 Ft. from N. Line

Ft. from S. Line

Ft. from E. Line

330 Ft. from W. Line

NW NW SW

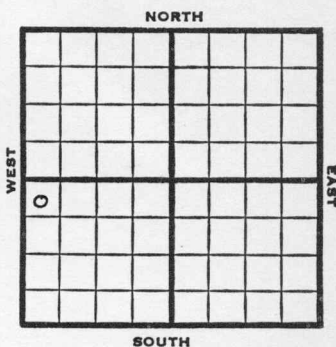

1952 Elev. 1788' REPORT

11/12 Spud 11-10-52

11/20 8" @ 176 Anhy 572' Topeka 2681'
 Heeb 2947' Br. li 3069' Lans 3084'
 Drlg. 3182'

11/27 NR

12/3 Spud 11-10-52

D&A

TD 3379'

8" @ 176

Anhy 572, Top. 2681, Heeb.

2947', Br. line 3069, Lans

3084, Cong. 3353, Arb. 3362

TD 3379

D&A

ABANDONED

County Barton State KansasSec. 21 (Blk.) 19 (Sur.) 11W Map No.Operator W. L. HartmanWell No. 2 Farm J. B. BirzerElev. Location NW NW SW

330 Ft. From N Line SW330 Ft. From W Line Quarter


1st. Report NOV 12 1952

Completion

Remarks

Garvey - Contr.Spudding Date 11-10-52

Drlg. Data

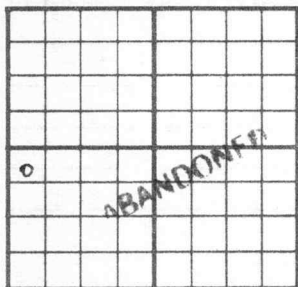County Barton State KansasSec. 21 (Blk. Twp.) 19 (Sur. Rge.) 11W Map No.Operator W. L. HartmanWell No. 2 Farm J. B. BirzerElev. 1788 Location NW NW SW330 Ft. From N Line SW330 Ft. From W Line Quarter1st. ReportCompletion DEC 3 1952RemarksGarvey - Contr.Spudding Date 11-10-52Drlg. Data D & A TD 33798" @ 176 Anhy 572 Top. 2681Heeb. 2947 Br. line 3069 Lans. 3084Cong. 3353 Arb. 3362 TD 3379D & A

J. G. McGEHEE