

KANSAS


FORM 51 5M 1-42 PETROL

Barton

Section 21 Township 19 Range 11-W

Well No. #1 Schwartz *(Schartz)*

Company Threeway Drilling

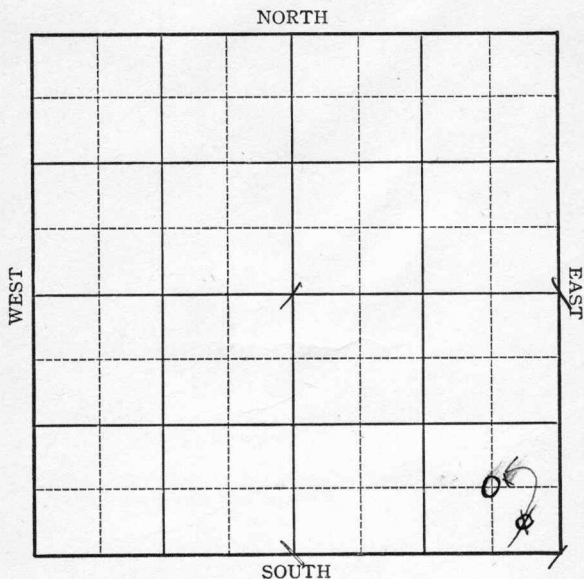

KANSAS

Barton

Sec. 21 Twp. 19 R. 11-W

Well No. #1 ~~Schwartz~~ Schartz Farm

Threeway Drilling Company


Silica

 Ft. from N. Line

660
~~330~~ Ft. from S. Line

660
~~330~~ Ft. from E. Line

 Ft. from W. Line

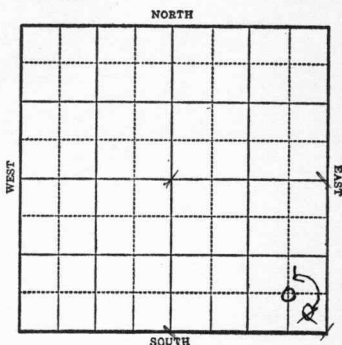

1943

R E P O R T

6/23

Location

6/30

224' Run 8"

7/7

10" @ 198'
Drilg. 2430'

7/14

Lans. 3063
Congl. 3338
Arb. 3352
T.D. 3382'


ABANDONED

KANSAS**Barton**Map No. 46 Sec. 21 Twp. 19 R. 11WWell No. 1 Schwartz**Threeway Drilling**

Company

FIRST REPORT

Contractor

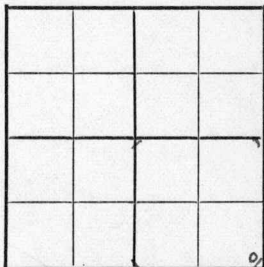SE/C**SECTION PLAT**

_____ Ft. from N. Line

330 Ft. from S. Line330 Ft. from E. Line

_____ Ft. from W. Line

SILICA POOLLocation XXX

Rig up _____

Drilling and Remarks:

RECORD

Cased _____ in., _____ ft.

Sand _____

Gas _____

Oil _____

Total Depth _____

PRODUCTION

1st 24 hrs. Nat. _____

1st 24 hrs. after shot _____

Gas _____ Cu. Ft.

Dry Hole _____

Abandoned _____

Date

JUN 23 1943 19S. J. LEWIS

Scout

Barton


KANSAS Map No. 6 Sec. 21 Twp. 19 R. 11W

Well No. 1 Scharztz**Threeway Drilling**

Company

CORRECTION

Contractor

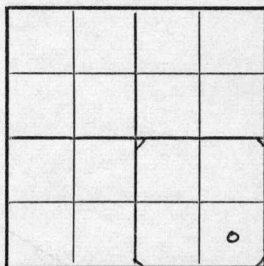C SE SE**SECTION PLAT**

_____ Ft. from N. Line

660 Ft. from S. Line660 Ft. from E. Line

_____ Ft. from W. Line

SI LICA POOL

Location _____

Rig up _____

Drilling and Remarks:

Reported SE/C**#1 Schwartz****RECORD**

Cased _____ in., _____ ft.

Sand _____

Gas _____

Oil _____

Total Depth _____

PRODUCTION

1st 24 hrs. Nat. _____

1st 24 hrs. after shot _____

Gas _____ Cu. Ft.

Dry Hole _____

Abandoned _____

Date

JUN 30 194319S. J. LEWIS

Scout

KANSAS

Barton

Map No. 46 Sec. 21 Twp. 19 R. 11WWell No. 1 Schartz

Threeway Drilling

Company

ABANDONED

Contractor

C SE SE

SECTION PLAT

			0

_____ Ft. from N. Line

660 Ft. from S. Line660 Ft. from E. Line

_____ Ft. from W. Line

SILICA POOL

Location _____

Rig up _____

Drilling and Remarks:

Loss 3063Congl 3338Gr 43352

RECORD

Cased _____ in., _____ ft.

Sand _____

Gas _____

Oil _____

Total Depth 3382

PRODUCTION

1st 24 hrs. Nat. _____

1st 24 hrs. after shot _____

Gas _____ Cu. Ft.

Dry Hole _____

Abandoned _____

Date

JUL 14 1943

19

S. J. LEWIS Scout