


Section 21 Township 19 Range 12W

Well No. #2 Brown

Company Pickerall Drlg.

NORTH

14

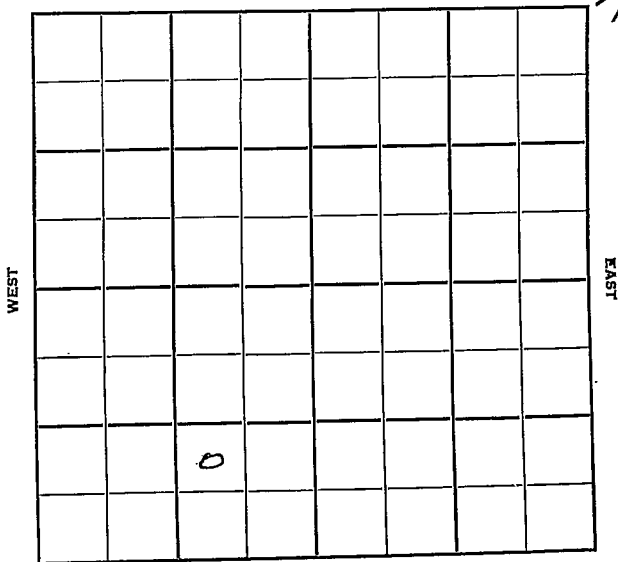

SOUTH

Barton **KANSAS** ✓

Sec. 21 Twp. 19 R. 12W

Well No. #2 Brown Farm

Pickerall Drlg. Company


Contractor

Ft. from N. Line

990' Ft. from S. Line

990' Ft. from E. Line

Ft. from W. Line

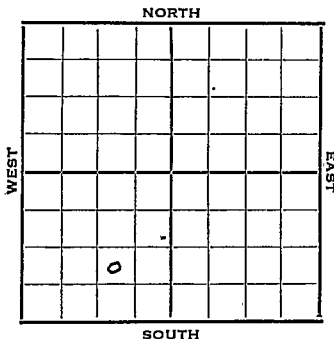

NW SE SW

1952 Elev. 1890' REPORT

5/7 Heeb. 3080 Br L 3195 Lans. 3211
DST 3262-72 1 hr. 270' oil
Cong. 3473 RTD 3505 5" @ 3466
WOCT

5/14 WOCT

5/21 POP

5/28 NR

6/11 NR

6/18 NR

6/25 "

7/2 "

7/9 Oil Well TD 3505
Heeb. 3080 Br Lime 3195
Lans. 3211
DST 3262-72 opn 1 hr. Rec. 270' oil
Cong. 3473 ID 3505 5" @ 3466
24/3347-55 500 A 32/3362-68
2000 A S/8 boph Comp. 40 bopd 40% w

COMPLETED

