DX 78-1


Barton

KANSAS

Section 21 Township 19 Range 12W

Well No. #2 Brown "D"

Company Petroleum Inc.

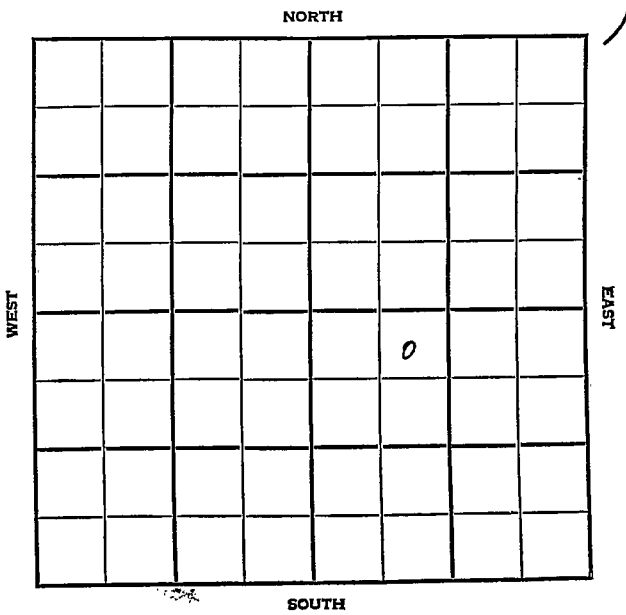

Barton KANSAS

SEC.	TWP.	R.
21	19	12W

WELL NO.

2 Brown "D" FARM

COMPANY

Petroleum, Inc.

CONTRACTOR

Garvey Drlg.


330 Ft. from N. Line

_____ Ft. from S. Line

_____ Ft. from E. Line

990 Ft. from W. Line

NE NW SE

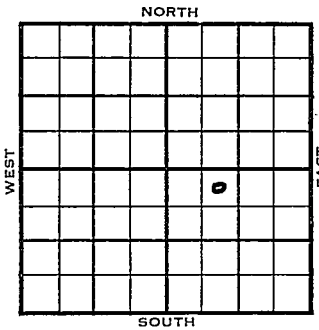

1955	ELEVATION 1865'	REPORT

1/5 Spud 12-31-54
8" @ 212'
Drlg. 1900'

1/12 Spud 12-31-54 - D&A
TD 3508'
8" @ 212'
Heeb. 3051', Tor. 3070', Br lime 3169', Lans 3185'
DST 3309-26', opn 1 hr., rec. 13' mud, 0#
DST 3344-65', opn 45", rec. 15' mud, 0#
Cong. 3462'
TD 3508'
D&A

ABANDONED

DX-78

FORM 275 FOR SALE BY KANSAS BLUE PRINT CO.


County Barton State Kansas

Sec. 21 (Blk. Twp.) 19 (Sur. Rge.) 12W Map No.

Operator Petroleum Inc.

Well No. 2 Farm Brown "D"

Elev. Location NE NW SE

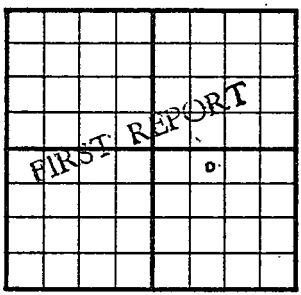

330 Ft. From N Line SE

990 Ft. From W Line Quarter

1st. Report JAN 5 1955

Completion

Remarks

Garvey Drlg. - Contr.

Spudding Date 12-31-54

Drlg. Data

8" @ 212 drlg. 1900

FABEN GILSTRAP

FORM 275 FOR SALE BY KANSAS BLUE PRINT CO.


County Barton State Kansas

Sec. 21 (Blk. Twp.) 19 (Sur. Rge.) 12W Map No.

Operator Petroleum Inc.

Well No. 2 Farm Brown "D"

Elev. 1865 Location NE NW SE

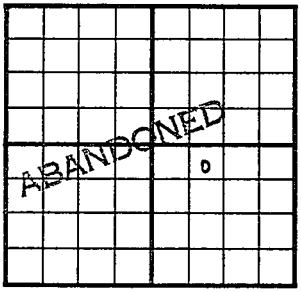

330 Ft. From N Line SE

990 Ft. From W Line Quarter

1st. Report

Completion JAN 1 2 1955

Remarks

Garvey Drlg. - Contr.

Spudding Date 12-31-54

Drlg. Data D & A TD 3508

8" @ 212 Heeb. 3051 Tor. 3070

Br. lime 3169 Lans. 3185 DST 3309-26

open 1 hr. Rec. 13' mud 0#

DST 3344-65 open 45 min. Rec. 15' mud

0# Cong. 3462 TD 3508

D & A

FABEN GILSTRAP