
FORM 51 25M 8-50 WESTERN

Barton KANSAS

Section 21 Township 19 Range 12W

Well No. #1 Brown

Company Branine & Holl

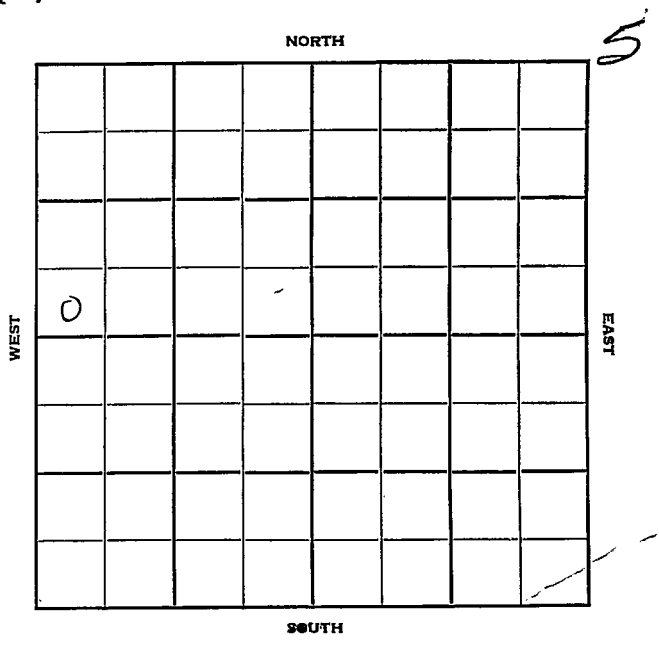

FORM 252-B
10M 10-50 PETROL

Barton KANSAS

Sec. 21 Twp. 19 R. 12W

Well No. #1 Brown Farm

Branine & Holl Company

Atlas Drlg. - Contr. Contractor

Wildcat


Ft. from N. Line

330' Ft. from S. Line

Ft. from E. Line

330' Ft. from W. Line

SW SW NW

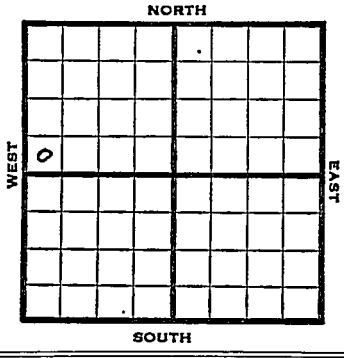

1950	Elev. 1896' REPORT
11/29	Spud 11-27-50
12/13	Spud 11-27-50 D&A TD 3543 8" @ 325 Top. 2810 Heeb. 3070 Br. lime 3184 Lans. 3199' Stain 3202-05 DST 3202-68 opn ½ hr Rec. 30' mud Cong. 3442' Simp. 3463 DST 3437-79 opn ½ hr Rec. 30' mud Arb. 3491 SSO 3491-94 DST 3436-95 opn ½ hr Rec. 70' mud TD 3543 D&A ABANDONED

FORM 275 FOR SALE BY KANSAS BLUE PRINT CO.


County Barton State Kansas

Sec. 21 (Blk. Twp.) 19 (Sur. Rge.) 12W Map No.

Operator Branine & Holl

Well No. 1 Farm Brown

Elev. Location SW SW NW

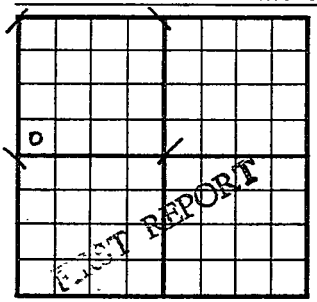

330 Ft. From S Line NW

330 Ft. From W Line Quarter

1st. Report NOV 2 9 1950

Completion

Remarks Atlas Drlg. - Contr.

Spudding Date 11-27-50

Drlg. Data Wildcat

J. E. TYRA

FORM 275 FOR SALE BY KANSAS BLUE PRINT CO.


County Barton State Kansas

Sec. 21 (Blk. Twp.) 19 (Sur. Rge.) 12W Map No.

Operator Branine & Holl

Well No. 1 Farm Brown

Elev. 1896 Location SW SW NW

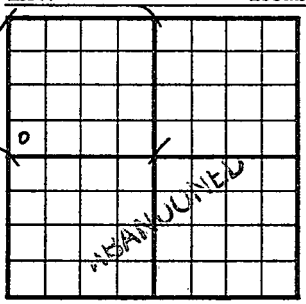

330 Ft. From S Line NW

330 Ft. From W Line Quarter

1st. Report

Completion DEC 13 1950

Remarks Wildcat

Atlas Drlg. - Contr.

Spudding Date 11-27-50

Drlg. Data D & A TD 3543

8" C 325 Top. 2810 Heeb. 3070

Br. lime 3184 Lans. 3199 Stain 3202-05

DST 3202-68 open ½ hr. Rec. 30' mud

Cong. 3442 Simp. 3463 DST 3437-79

open ½ hr. Rec. 30' mud Arb. 3491

SSO 3491-94 DST 3436-95 open ½ hr.

Rec. 70' mud TD 3543

D & A

J. E. TYRA