


KANSAS

Section 21 Township 19 Range 10-W

Well No. #1 Eatinger

Company Cities Service Oil
(Silica)

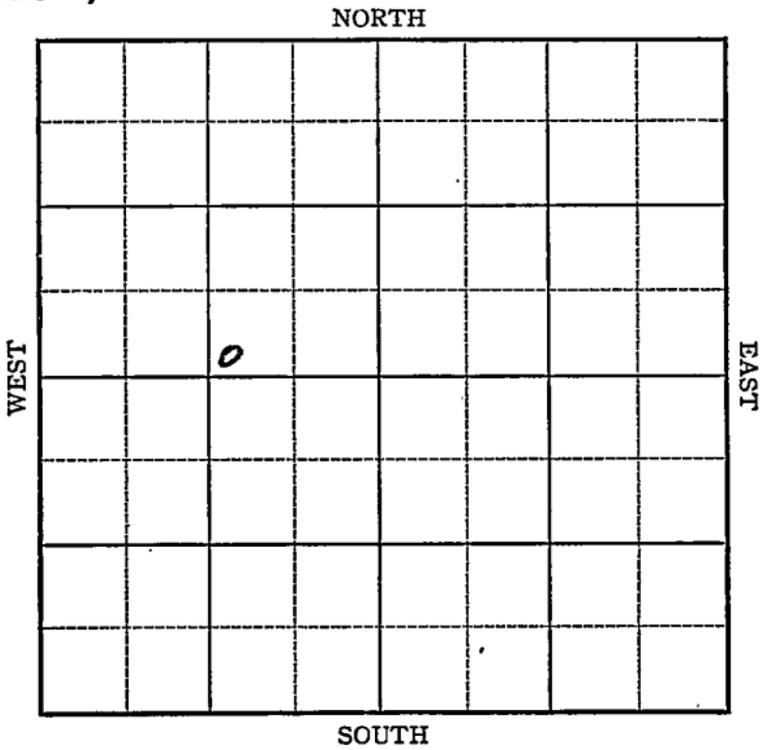

Sec. 21 Twp. 19 R. 10-W

Well No. #1 Eateringer Farm

Cities service oil Company

(Silica pool)


_____ Ft. from N. Line

330 Ft. from S. Line

990 Ft. from E. Line

_____ Ft. from W. Line

Elev. 1764

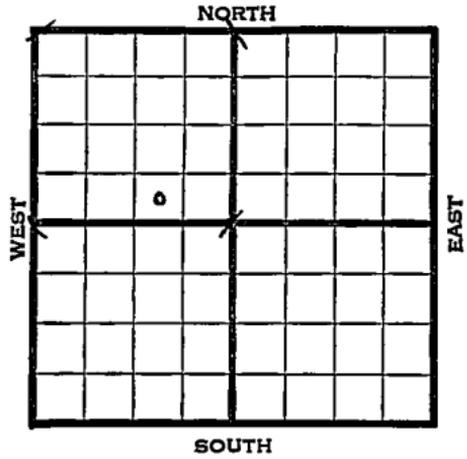

1941	REPORT
8/6	8" - 150' WOC
8/15	Drlg. 3032'
8/21	Arb. 3297-3301' T.D. 5" - 3298' RUST.
8/28	T.D. 3325' 400' water. P.B. to 3238'
9/3	Arb. 3297' 5" - 3298' T.D. 3325' P.B. to 3238' 65 shots 3043-54' 3000 acid. Pump 733 oil & 110 water. 45. Gravity
	COMPLETED

Map No. KANSAS Sec. 21 Twp. 19 R. 10W

Well No. 1 Eatinger

Cities Service Oil Company

FIRST REPORT Contractor

SW SE NW

_____ Ft. from N. Line


330 Ft. from S. Line

990 Ft. from E. Line

_____ Ft. from W. Line

SILICA POOL

SECTION PLAT

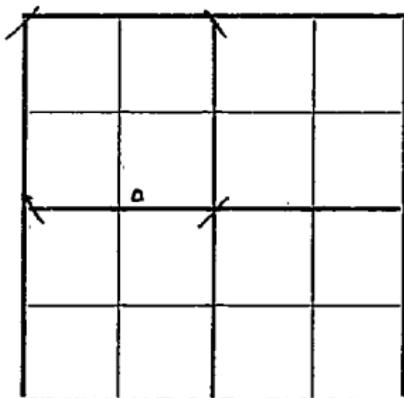

Location _____

Rig up _____

Drilling and Remarks:

8" - 150 WOC

RECORD

Cased _____ in., _____ ft.

Sand _____

Gas _____

Oil _____

Total Depth _____

PRODUCTION

1st 24 hrs. Nat. _____

1st 24 hrs. after shot _____

Gas _____ Cu. Ft.

Dry Hole _____

Abandoned _____

Date

AUG 6 1941 19

S. J. LEWIS Scout

4

11/10/1911

PAID

Misc Small Maps	
Cards	<i>one</i>
Tracing	<i>one</i>
France map	<i>one</i>
Scarborough Map	<i>one</i>
copy	<i>one</i>
copy of map	<i>one</i>
copy of Back	

Map No. 46 Sec. 21 Twp. 19 R. 10WWell No. 1 EatingerCities Service Oil

Company

Contractor

COMPLETED**SECTION PLAT**

SW SE NW

Ft. from N. Line

330

Ft. from S. Line

990

Ft. from E. Line

Ft. from W. Line

SILICA POOL

	0		

Location _____

Rig up _____

Drilling and Remarks:

*CE 8 3297**5" @ 3298**PA 3235**654 hrs to 3043-54**3000 Acid**Pump 783 oil 110 W 118**45-c. gas***RECORD**

Cased _____ in., _____ ft.

Sand _____

Gas _____

Oil _____

Total Depth 3325**PRODUCTION**

1st 24 hrs. Nat. _____

1st 24 hrs. after shot _____

Gas _____ Cu. Ft.

Dry Hole _____

Abandoned _____

Date

SEP 3

1941

19

S. J. LEWIS

Scout

Misc Small Maps.....
Cards.....
Tracing.....
France Map.....
Scarborough Map.....
Moody Map.....
Geological Dept.
Moody Plat Book

