


KANSAS

Section 21 Township 19 Range 10W

Well No. #2 Eatinger

Company Cities Service

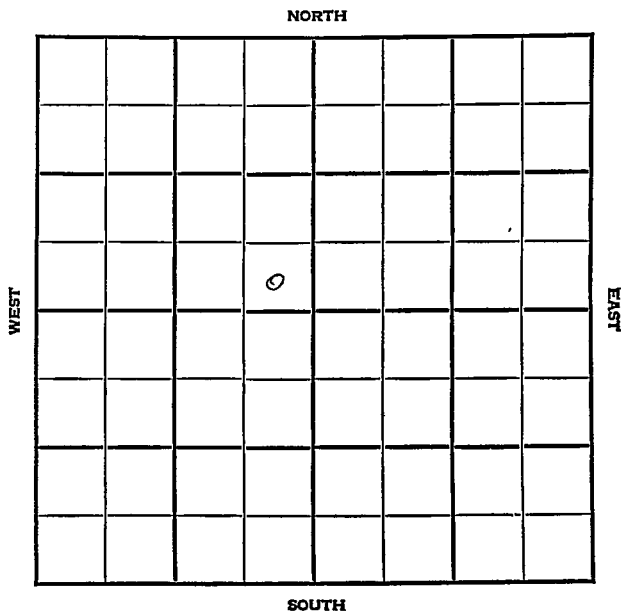

Sec. 21 Twp. 19 R. 10-W

Well No. #2 Eatinger Farm

Cities Service Company

Silica Pool


Ft. from N. Line

330' Ft. from S. Line

330' Ft. from E. Line

Ft. from W. Line

SE NW

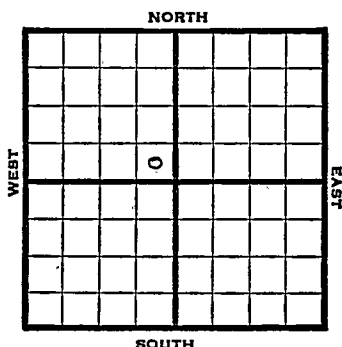

1947 Elev. 1768' REPORT

11/25	RUR
12/3	8" @ 240' Drlg. 2564'
12/10	Drlg. 3295'
12/17	Arbuckle 3302' TD 3304' 5" @ 3303' RUST
12/30	TD 3312' 500 acid Pump 6 bbls. oil / 56 W PB
1948 1/7	PB 3238' 52 shots 3034-48' 1127' water / 50' oil 36 hrs. Squeeze.
1/14	Lansing 2956' 20 shots 3030-38' 500 acid Pumped 27 bbls oil & 57 W in 4½ hrs
1/21	500 Acid Pump 107 bbls of / 200 W in 24 hrs.

OVER

1948

1/28 Lans. 2956'
 Arb. 3302'
 5" @ 3303'
 Perf. Lans.
 1000 acid.
 Pump 107 oil / 200 W pot.
 42.0 Gr.
 TD 3312'
 Comp.

COMPLETED

Map No. _____ Sec. 21 Twp. 19 R. 10W

Well No. 2 Eatinger

Cities Service

Company

FIRST REPORT

Contractor

SE NW

SECTION PLAT

_____ Ft. from N. Line

330 Ft. from S. Line

330 Ft. from E. Line

_____ Ft. from W. Line

Rice County

Location _____

Rig up _____

Drilling and Remarks:

R U R

RECORD

Cased _____ in., _____ ft.

Sand _____

Gas _____

Oil _____

Total Depth _____

PRODUCTION

1st 24 hrs. Nat. _____

1st 24 hrs. after shot _____

Gas _____ Cu. Ft.

Dry Hole _____

Abandoned _____

Date

NOV 25 1947

19

S. J. LEWIS

Scout

Wm

Misc. Small Maps	☒
Cards	☒
Tracing	☒
ance Map	☒
orough Map	☒
Map	☒
Map	☒
Map	☒

avg

Map No. 46 Sec. 21 Twp. 19 R. 10W

Well No. 2 Eatinger


Cities Service Company

COMPLETE

Contractor

SE NW

E11768
SECTION PLAT

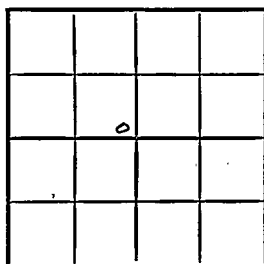

 Ft. from N. Line

330 Ft. from S. Line

330 Ft. from E. Line

 Ft. from W. Line

Rice County

Location

Rig up

Drilling and Remarks:

Lease 2956

Cr Y8302.

5" @ 3303

Perf Leas.

10000000

Pump 10 7 oil + 200 H

P.S.

RECORD

Cased in., ft.

Sand

Gas

Oil ✓

Total Depth 33 1/2

PRODUCTION

1st 24 hrs. Nat.

1st 24 hrs. after shot

Gas Cu. Ft.

Dry Hole

Abandoned

Date

42 2/28

JAN 28 1948

19

S. J. LEWIS

Scout

Misc. Small Maps

Cards

Tracing

France Map

Scarborough Map

Pierce Map

Geological Dept.

Pierce Plot Book