

KANSAS


FORM 51 5M 4-41 PETROL

Rice

Section 21 Township 19 Range 10W

Well No. 1 Hennie

Company Sharon Drilling

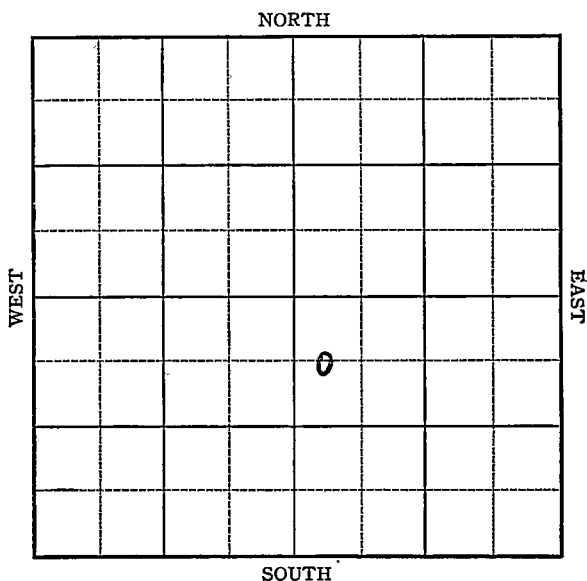

KANSAS


Rice

Sec. 21 Twp. 19 R. 10-WWell No. #1 Hemie FarmSharon Drilling Company

(Silica)

660 Ft. from N. Line Ft. from S. Line Ft. from E. Line330 Ft. from W. Line

Elev. 1762

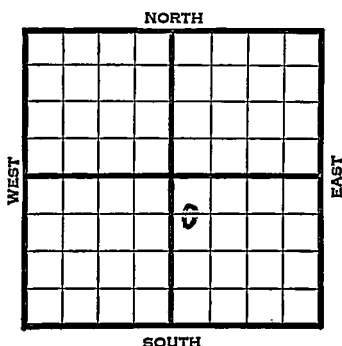

1941

REPORT

6/4	Location
6/12	8" - 195' Anhy 450'
	Drlg. 2485'
6/19	Lans. 2963' S.O. 3036-57'
	Arb. 3295 3295 97' T.D. 5" - 3295 3295'
	RUST.
6/26	Arb. 3295' (Corrected)
	5" - 3295' T.D. 3301'
	Swab 184 oil.
7/1	Arb. 3295'
	5" - 3295'
	T.D. 3301'
	Potential 466 bbls., pump.
	45. Gravity

COMPLETED

Map No. 46 Sec. 21 Twp. 19 R. 10WWell No. 1 HennieSharon Drilling Company

Contractor

FIRST REPORT

C W L NW SE

660 Ft. from N. Line Ft. from S. Line Ft. from E. Line330 Ft. from W. Line

SECTION PLAT

		o	

SILICA POOL

Location XRig up

Drilling and Remarks:

RECORD

Cased in., ft.Sand Gas Oil Total Depth

PRODUCTION

1st 24 hrs. Nat. 1st 24 hrs. after shot Gas Cu. Ft.Dry Hole Abandoned

Date

JUN 4 1941S. J. LEWIS

Scout

Misc. Small Maps

Cards

Tracing

France Map

Scarborough Map

Moody Map

Geological Dept.

Moody Plat Book

Map No. 46 Sec. 21 Twp. 19 R. 10WWell No. 1 HennieSharon Drilling

Company

COMPLETED

Contractor

SECTION PLAT

C W L NW SE

660 Ft. from N. Line

Ft. from S. Line

Ft. from E. Line

330 Ft. from W. Line

SILICA POOL

		o	

RECORD

Location _____

Cased _____ in., _____ ft.

Rig up _____

Sand _____

Drilling and Remarks:

Gas _____

Oil _____

Total Depth 3301

PRODUCTION

1st 24 hrs; Nat. _____

1st 24 hrs; after shot _____

Gas _____ Cu. Ft.

Dry Hole, _____

Abandoned _____

Date

JUL 1 1941 19S. J. LEWIS Scout

Ar 8295
5" @ 3295
Pump 466 Pst

45° E

Misc Small Maps
Cards
Tracing
France Map
Scarborough Map
Moody Map
Geological Dept.
Moody Plat Book