

KANSAS

Rice

Section 21 Township 19 Range 10WWell No. 4 Knop "A"Company Skelly

Chase

NORTH

0							

WEST

EAST

SOUTH

Rice KANSAS

Sec. 21 Twp. 19 R. 10W

Well No. #4 Knop "A" Farm

Skelly


Chase Pool (Wentworth Drlg., Cont.) Company

330' Ft. from N. Line

 Ft. from S. Line

 Ft. from E. Line

330' Ft. from W. Line

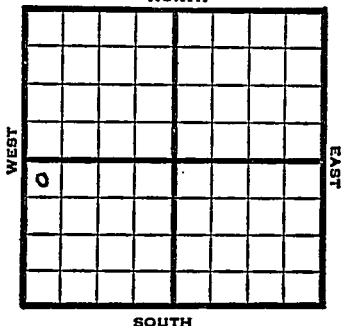

NW SW

1949 Elev 1772' REPORT

8/3 Location
8/10 8" @ 450'
Drlg 2818'
8/17 Lansing 2978'
Arb. 3278-83'
TD 3283'
5" @ 3280'
8/24 TD 3283'
Swb 21 bbls oil 5 hrs.
8/31 "
9/7 "
9/14 TD 3283'
Lans 2978'
Arb. 3278'
5" @ 3280'
Perf Lans.
1500 acid
Pump 53 Oil Pot
42° Gr.
Comp

COMPLETED

Kansas

Chase Pool

Map No. _____ Sec. 21 Twp. 19 R. 10WWell No. 4 Knop "A"

Skelly _____ Company

Wentworth Drlg. _____ Contractor

NW SW

FIRST REPORT
SECTION PLAT330 Ft. from N. Line

_____ Ft. from S. Line

_____ Ft. from E. Line

330 Ft. from W. Line

o			

Rice County

Location ✓

Rig up _____

Drilling and Remarks: _____

RECORD

Cased _____ in., _____ ft.

Sand _____

Gas _____

Oil _____

Total Depth _____

PRODUCTION

1st 24 hrs. Nat. _____

1st 24 hrs. after shot _____

Gas _____ Cu. Ft.

Dry Hole _____

Abandoned _____

Date

AUG 3 1949 19S. J. LEWIS

Scout

Scout Cards	☒
Land Small Map	☒
Land Wall Map	☒
Tracings	☒
France Map	☒
Pi r e Map	☒
Misc,	☐

Map No. K46 Sec. 21 Twp. 19 R. 10W

Well No. 4 Knop "A"

Skelly Company

COMPLETE

Contractor

NW SW

E 11772

SECTION PLAT

330 Ft. from N. Line

 Ft. from S. Line

 Ft. from E. Line

330 Ft. from W. Line

4			

Rice County

Location

Rig up

Drilling and Remarks:

Lane 2978
Per 3278.
5" C 3280
Perf. Lane.
1500 acid
Imp Oil Rt

RECORD

Cased in., ft.

Sand

Gas

Oil

Total Depth 3280

PRODUCTION

1st 24 hrs. Nat.

1st 24 hrs. after shot

Gas Cu. Ft.

Dry Hole

Abandoned

Date

42 2/28

SEP 14 1949 19

S. I. LEWIS Scout

Scout Cards	Smith
Land Small Map	
Land Wall Map	
Tracings	
France Map	
Pierce Map	
Misc.	