

Sec. 21 Twp. 19 R. 10W ✓

Well No. #3 Eatinger Farm

J. Bergman Company


Silica Pool

990' Ft. from N. Line

_____ Ft. from S. Line

_____ Ft. from E. Line

330' Ft. from W. Line

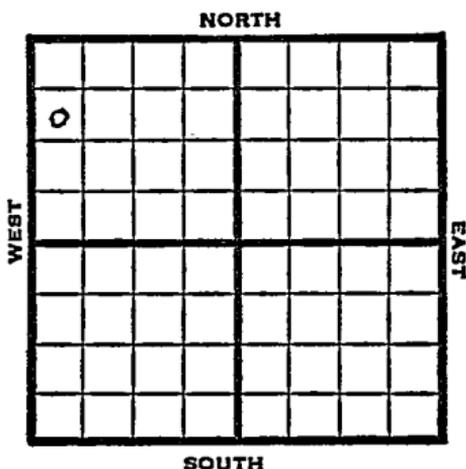

SW NW NW

1949

Elev 1766' REPORT

5/3 Location
5/10 "
5/18 10" @ 151
Drlg 2890'
5/25 Lans. 2956'
Dong 3241'
Quartzite 3276-79'
TD 3279
5" @ 3279'

6/1 TD 3279'
Quartzite 3276'
Aband.

ABANDONED

Map No. _____ Sec. 21 Twp. 19 R. 10W

Well No. 3 Eatinger

J. Bergman _____ Company

Pabco Drlg. _____ Contractor

SW NW NW

**FIRST REPORT
SECTION PLAT**

990 Ft. from N. Line

_____ Ft. from S. Line

_____ Ft. from E. Line

330 Ft. from W. Line

Rice County

Location X

Rig up _____

Drilling and Remarks:

RECORD

Cased _____ in., _____ ft.

Sand _____

Gas _____

Oil _____

Total Depth _____

PRODUCTION

1st 24 hrs. Nat. _____

1st 24 hrs. after shot _____

Gas _____ Cu. Ft.

Dry Hole _____

Abandoned _____

Date

MAY 11 1949 19

S. J. LEWIS Scout

Scout Cards	
Land Small Map	
Land Wall Map	
Tracings	
France Map	
Pierce Map	
Misc.	

Kansas

Map No. K46 Sec. 21 Twp. 19 R. 10WWell No. 3 EatingerJ. Bergman

Company

ABANDONED

Contractor

SW NW NW

E11766
SECTION PLAT990 Ft. from N. Line

_____ Ft. from S. Line

_____ Ft. from E. Line

330 - Ft. from W. Line

6			

Rice County

RECORD

Location _____

Cased _____ in., _____ ft.

Rig up _____

Sand _____

Drilling and Remarks:

Gas _____

Quartzite 0276

Oil _____

Total Depth 0279

PRODUCTION

1st 24 hrs. Nat. _____

1st 24 hrs. after shot _____

Gas _____ Cu. Ft.

Dry Hole _____

Abandoned _____

Date

JUN 1 1949 19S. J. LEWIS Scout

Scout Cards *Edith*
Land Small Map
Land Wall Map
Tracings
France Map
Pierce Map
Misc.