


KANSAS

Section 21 Township 19 Range 10-W

Well No. #6 Eatinger

Company J Bergman

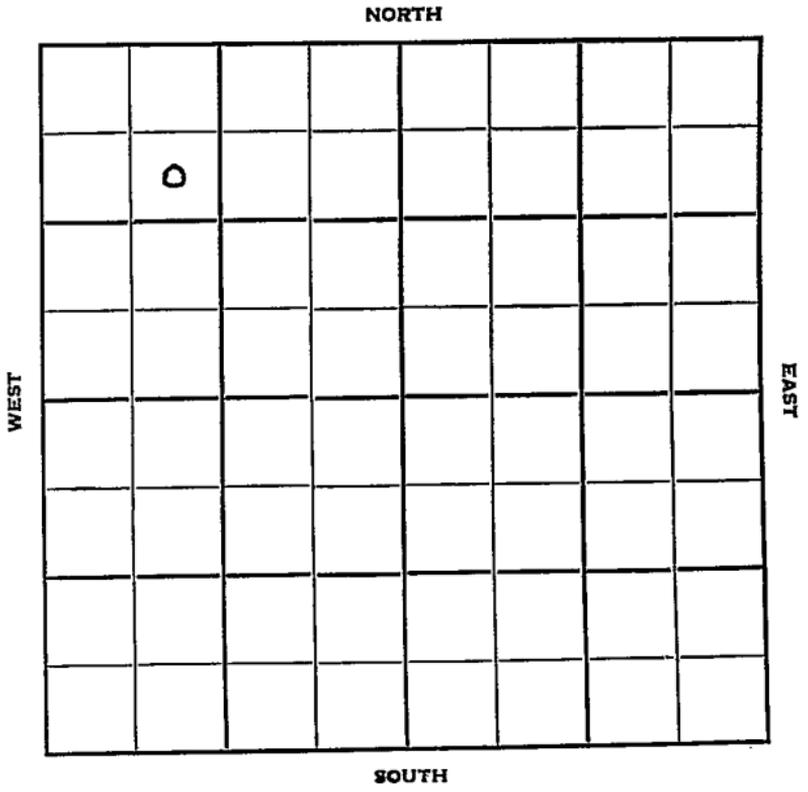

Sec. 21 Twp. 19 R. 10-W

Well No. #6 Eatinger Farm

J. Bergman Company

Murfin Drlg. Contractor

Silica


990 Ft. from N. Line

_____ Ft. from S. Line

_____ Ft. from E. Line

990 Ft. from W. Line

SE NW NW

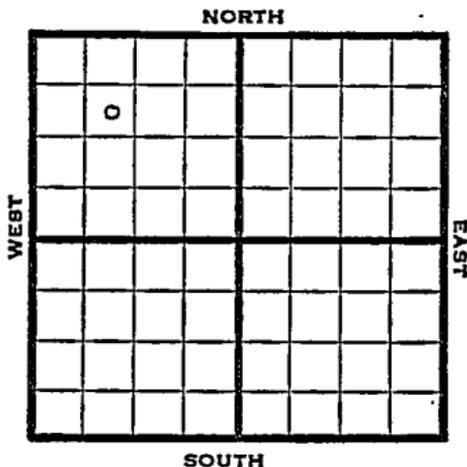

1950 Elev. 1768' REPORT

11/1 Spud 10-25-50
8 5/8" @ 151
WOC

11/15 Spud 10-25-50
D&A TD 3298
8-5/8" @ 151'
Lans. 2978' Cong. 3260'
Arb. 3287-98 TD
D&A

ABANDONED

NOV 6 1950

Scout Cards	7-10
Land Small Map	3
Land Wall Map	
Tracings	
France Map	
Pierce Map	
Misc.	

Orig. Data

NOV 21 1950

Scout Cards
Land Small Map
Land Wall Map
Tracing
France Map
Pierce Map
Misc.

Orig. Data