


Rice

Section 21 Township 19 Range 10W

Well No. #1 Heine "B"

Company Sharon Drlg.

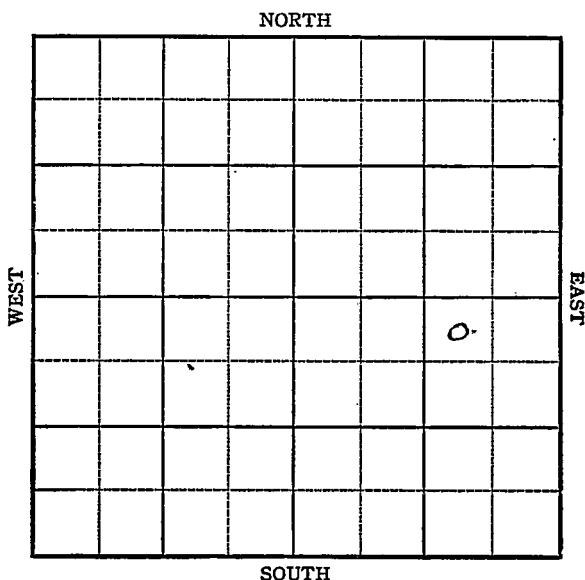

Sec. 21 Twp. 19 R. 10W

Well No. #1 Heine "B" Farm

Sharon Drlg. Company

Silica


330 Ft. from N. Line

Ft. from S. Line

990 Ft. from E. Line

Ft. from W. Line

NW NE SE

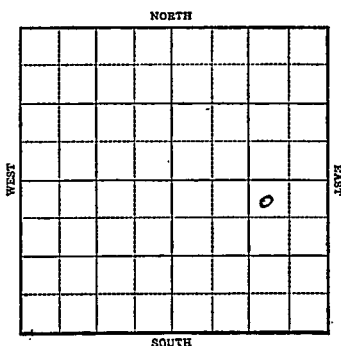

R E P O R T

1944

2/9

Location

2/15

"

2/23

Rotary

3/1

8" @ 204
Anhy 435
Drlg. 1935

3/8

" "

3/16

Cong. 3294
Arb. 3312-18 TD
5" @ 3312
Rust

3/22

Swb 40 oil in 24 hrs.

3/29

5" @ 3312
1500 acid
TD 3318
Arb. 3312
Pump 40 Pot
Gravity 42.0

COMPLETED

KANSAS

Map No. 76 Sec. 21 Twp. 19 R. 10WWell No. 1 Heine "B"

Sharon Drlg.


Company

FIRST REPORT

Contractor

NW NE SE

SECTION PLAT

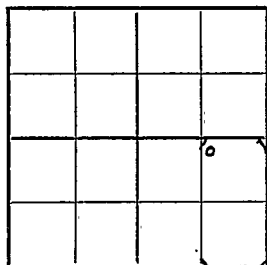330 Ft. from N. Line

Ft. from S. Line

990 Ft. from E. Line

Ft. from W. Line

Silica Pool

Location X

Rig up

Drilling and Remarks:

RECORD

Cased _____ in., _____ ft.

Sand _____

Gas _____

Oil _____

Total Depth _____

PRODUCTION

1st 24 hrs. Nat. _____

1st 24 hrs. after shot _____

Gas _____ Cu. Ft.

Dry Hole _____

Abandoned _____

Date

FEB 9 1944 19S. J. LEWIS Scout

Misc. Small Maps

Cards

Tracing

France Map

Scarborough Map

Moody Map

Geological Dept.

Moody Plat Book

Map No. KANSAS Sec. 21 Twp. 19 R. 10W

Well No. 1 Heine "B"

Sharon Drlg.

Company

COMPLETED

Contractor

NW NE SE

SECTION PLAT

330

Ft. from N. Line

Ft. from S. Line

990

Ft. from E. Line

Ft. from W. Line

			6

Silica Pool

Location

Rig up

Drilling and Remarks:

Cr 73312

5' 03312

1500 acid

Pray 40 ft

42 = Gr

RECORD

Cased _____ in., _____ ft.

Sand _____

Gas _____

Oil _____

Total Depth 338

PRODUCTION

1st 24 hrs. Nat. _____

1st 24 hrs. after shot _____

Gas _____ Cu. Ft.

Dry Hole _____


Abandoned _____

Date

MAR 29 1944

19

S. J. LEWIS Scout

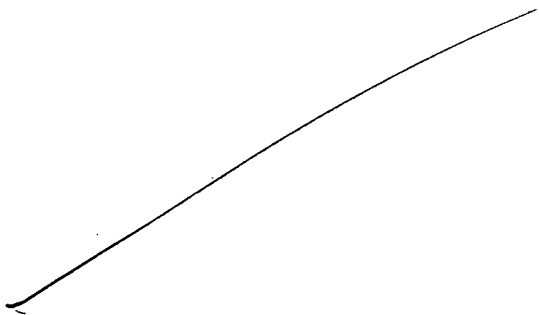

Misc	Ona
Madge	
V. E. L.	
Moody	MEZ
Geological Dept.	
Moody Plat Book	