

Rice


KANSAS

FORM 51 5M 2-38 TPCO.

Section 21 Township 19 Range 10-W


Well No. 1 W. Heine

Company Stanolind

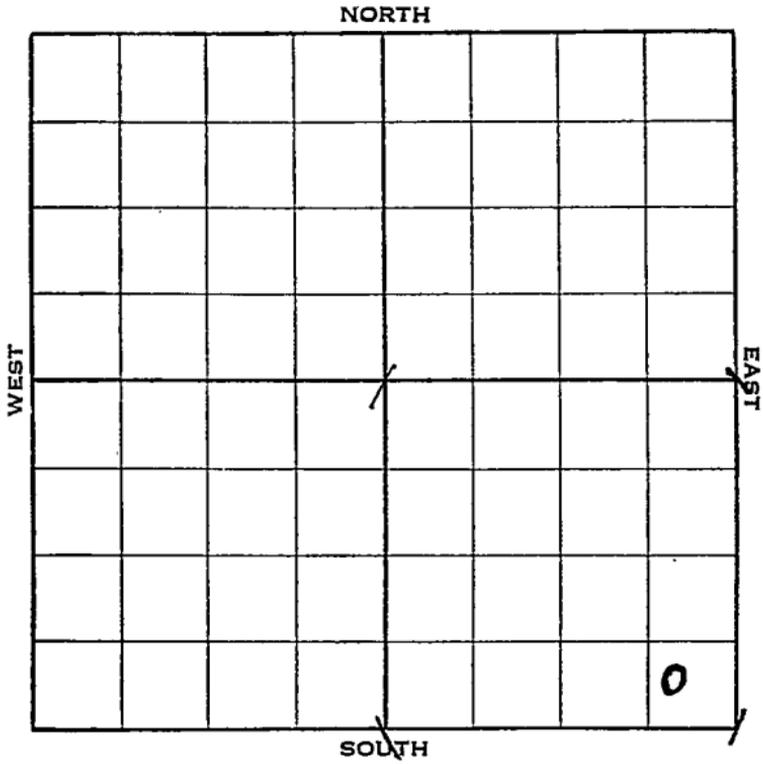





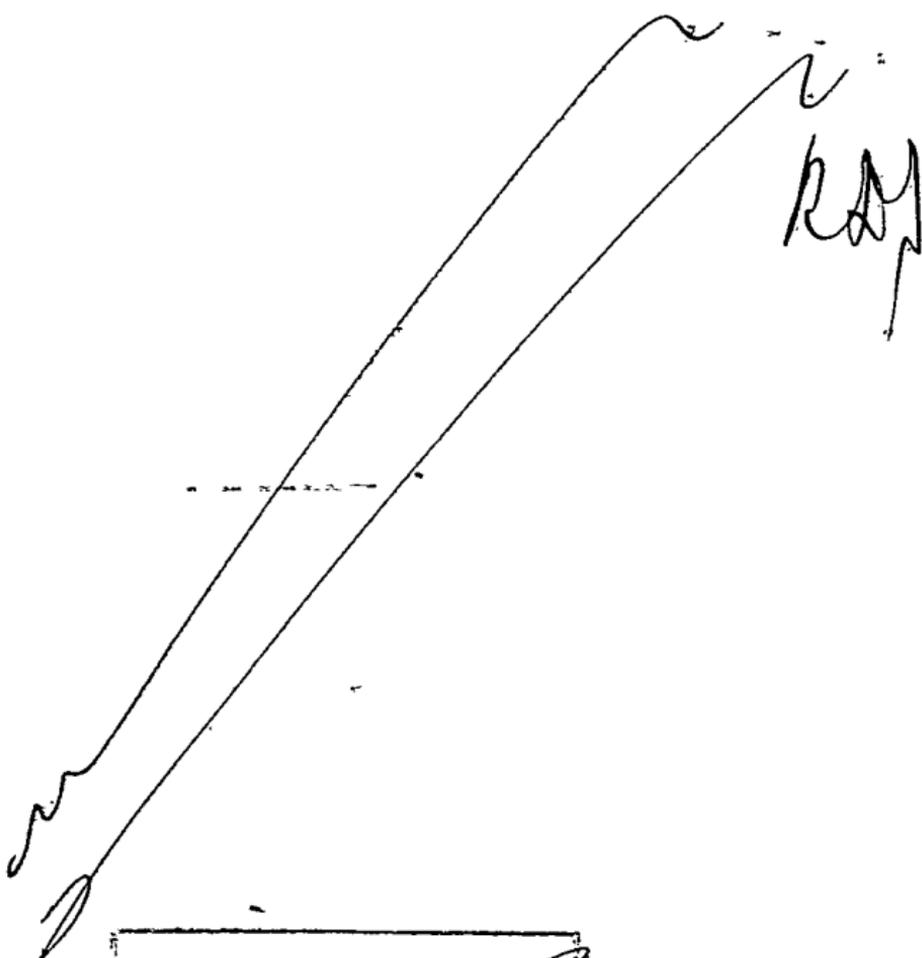

Paul	
Joe	
Moody Map	
Searborough Flat Book	
Moody Flat Book	

*RAY*

Map No. \_\_\_\_\_ Sec. 21 Twp. 19 R. 10W

Well No. 1 W. Heine

Stanolind

Company

Contractor

ABANDONED

SE/C

SECTION PLAT

\_\_\_\_\_ Ft. from N. Line

330 Ft. from S. Line

440 Ft. from E. Line

\_\_\_\_\_ Ft. from W. Line

			0

Location \_\_\_\_\_

Rig up \_\_\_\_\_

Drilling and Remarks:

*10 gts 3321-25*  
*1000 acid*  
*HFW*  
*DYA*

RECORD

Cased 7 in., 3320 ft.

Sand Ab 3320

Gas \_\_\_\_\_

Oil \_\_\_\_\_

Total Depth 3325

PRODUCTION

1st 24 hrs. Nat. \_\_\_\_\_

1st 24 hrs. after shot \_\_\_\_\_

Gas \_\_\_\_\_ Cu. Ft.

Dry Hole \_\_\_\_\_

Abandoned \_\_\_\_\_

Date

NOV 9 - 1938

19

H. D. Hatfield

Scout

Misc. Small Maps

Cards

Tracing

France Map

Scarborough Map

Moody Map

Geological Dept.

Moody Flat Dock

*RAY*  
*RAY*  
*JR*  
*RAY*  
*RAY*