

Section 21 Township 19 Range 10WWell No. #5 Knop "A"Company Skelly

Silica Pool

NORTH

|  |  |  |  |  |  |  |  |
|--|--|--|--|--|--|--|--|
|  |  |  |  |  |  |  |  |
|  |  |  |  |  |  |  |  |
WEST

EAST

SOUTH

Sec. 21 Twp. 19 R. 10WWell No. #5 Knop "A" Farm

Skelly

Silica Pool


990' Ft. from N. Line

Ft. from S. Line

330' Ft. from E. Line

Ft. from W. Line

SE NE SW

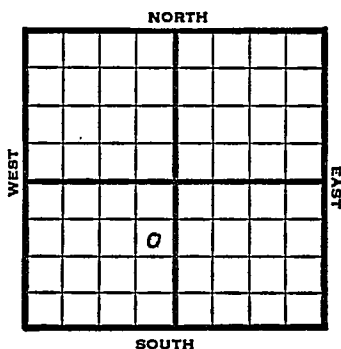

1949

Elev. 1764' REPORT

12/21

Location

12/28

8" @ 445'

1950

2/22

8" @ 445'

5" @ 3292'

Lans 2957'

Arb 3291'

53 BOPD

7 BWPD

TD 3302'

**COMPLETED**

1954

5/19

**O. W. P. B.**

Oil well TD 3303'

Heeb 2809' Br. lime 2931' Lans 2960'

Cong. 3267' Arb. 3291'

OTD 3303' 5" @ 3295' PB 3240

115/3129-44 500 A S/5 BO 5 hr.

2500 A S/10 BO 3 BW 4 hr.

PB 3105 24/3096-3100 24/3090- 94

500 A B/1/2 GWPH 6 hr. PB 3052

70/3029-41 500 A S/7 BO 16 BW

5 hr. CO to 3240

Comp. 33 BOPD 48 BW

**FIRST REPORT****COMPLETED**

Map No. \_\_\_\_\_ Sec. 21 Twp. 19 R. 10W

Well No. 5 Knop "A"

Skelly

Company

SE NE SW

FIRST REPORT Contractor

SECTION PLAT

990 Ft. from N. Line

Ft. from S. Line

330 Ft. from E. Line

Ft. from W. Line

|  |  |  |  |
|--|--|--|--|
|  |  |  |  |
|  |  |  |  |
|  |  |  |  |
|  |  |  |  |
|  |  |  |  |

Rice County

Location X

Rig up

Drilling and Remarks:

RECORD

Cased \_\_\_\_\_ in., \_\_\_\_\_ ft.

Sand \_\_\_\_\_

Gas \_\_\_\_\_

Oil \_\_\_\_\_

Total Depth \_\_\_\_\_

PRODUCTION

1st 24 hrs. Nat. \_\_\_\_\_

1st 24 hrs. after shot \_\_\_\_\_

Gas \_\_\_\_\_ Cu. Ft.

Dry Hole \_\_\_\_\_

Abandoned \_\_\_\_\_

Date

DEC 21 1949 19

S J LEWIS

Scout

DEC 23 1949

Scout Cards  
Land Small Map  
Land Wall Map  
Tracings  
France Map  
Pierce Map  
Misc.

Map No. \_\_\_\_\_ Sec. 21 Twp. 19 R. 10WWell No. 5 Knop "A"Skelly

Company

Contractor


SE NE SW

E. 1764  
SECTION PLAT990 Ft. from N. Line

\_\_\_\_\_ Ft. from S. Line

330 Ft. from E. Line

\_\_\_\_\_ Ft. from W. Line

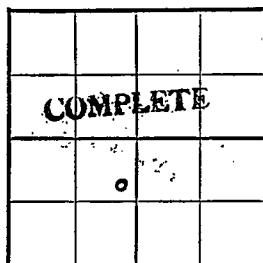Rice County

Location \_\_\_\_\_

Rig up \_\_\_\_\_

Drilling and Remarks:

8' @ 445  
5' @ 3292  
Lanz 2957  
and 3291  
53 BOPD  
78WPD

## RECORD

Cased \_\_\_\_\_ in., \_\_\_\_\_ ft.

Sand \_\_\_\_\_

Gas \_\_\_\_\_

Oil \_\_\_\_\_

Total Depth 3302

## PRODUCTION

1st 24 hrs. Nat. \_\_\_\_\_

1st 24 hrs. after shot \_\_\_\_\_

Gas \_\_\_\_\_ Cu. Ft.

Dry Hole \_\_\_\_\_

Abandoned \_\_\_\_\_

Date

CFEB 22 1950 19J. E. TYRA

Scout


100-20000-10000





 



Scout Cards  
Land Small M  
Land With M  
Tracing  
Frame  
Pierce  
Misc.

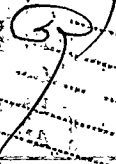

MAR-2

1933

O. W. P. B.

County **Rice** State **Kansas**

Sec. **21** (Blk. **19** (Sur. **10W** Map No.

Operator **Skelly Oil**

Well No. 5 Farm Knop "A"

|       |      |          |          |
|-------|------|----------|----------|
| Elev. | 1767 | Location | SE NE SW |
|-------|------|----------|----------|

**FIRST REPORT**

0

**COMPLETE**

990 Ft. From N Line SW

330 Ft. From E Line Quarter

1st. Report **MAY 19 1954**

Completion MAY 19 1954

Remarks (OWPB)

O. W. P. B.

Spudding Date:

Drilg. Data      Oil well      TD 3303

Heeb. 2809 Br. lime 2931 Lans. 2960

Cong. 3267    Arb. 3291    OTD 3303    5" @

3295 PB 3240 115/ 3129-44 500 A

S/ 5 bo 5 hr. 2500 A S/ 10 bo 3 bw

4 hr. PB 3105 24/ 3096-3100 25/ 3090-

94 500 A B/ $\frac{1}{2}$  graph 6 hr. PB 3052

70/ 3029-41 500 A S/ 7 bo 16 bw 5 hr

CO to 5240 Comp. 33 bopd 48 bw

J. G. McGEHEE

|                |           |
|----------------|-----------|
| Secret Cards   | <i>mm</i> |
| Land Small Map |           |
| Land Wall Map  |           |
| Tracings       |           |
| France Map     |           |

MAY 20 1954

Orig. Data.