

KANSAS

Rice

FORM 51 5M 4-41 PETROL

Section 21 Township 19 Range 10-W

Well No. 2 Neidus


Company Sharon Drilling

Silica Pool

NORTH

WEST

EAST

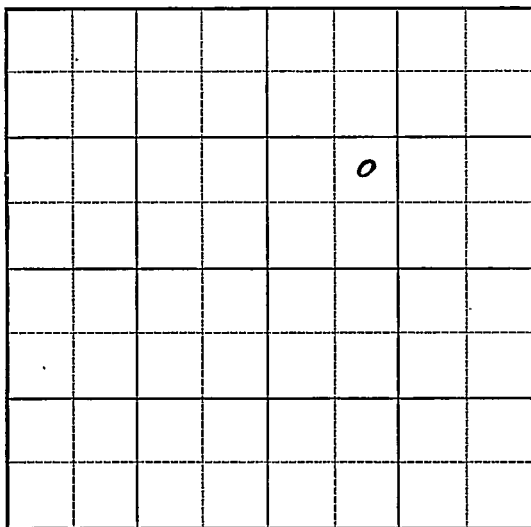

SOUTH

Sec. 21 Twp. 19 R. 10-W

Well No. #2 Neidus Farm

Sharon Drilling Company

(Silica)


 Ft. from N. Line

990 Ft. from S. Line

 Ft. from E. Line

990 Ft. from W. Line

Elev. 1762

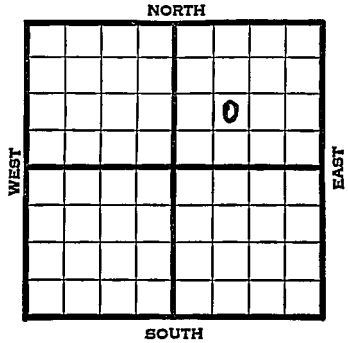

1941

REPORT

5/7

8" - 145'

Drlg. 2350'

5/15

Lans. 2974' Cong. 3290'

Drlg. 3309'

5/22

Arb. 3320-43' T.D. 5" - 3116'

No shows. 25 shots 3044-65'

Testing.

5/27

Arb. 3320'

5" - 3116'

Lans. 2974'

T.D. 3343'

25 shots 3044-3065'

500 acid.

43.2 Gravity


Potential 21 bbls., pump.

COMPLETED

Map No. 46 Sec. 21 Twp. 19 R. 10WWell No. 2 NeidusSharon Drilling CompanyFIRST REPORT Contractor

SECTION PLAT

NE SW NE

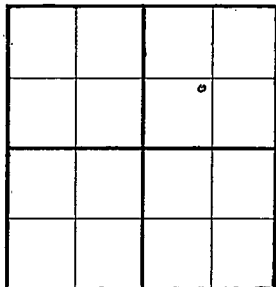 Ft. from N. Line990 Ft. from S. Line Ft. from E. Line990 Ft. from W. Line

SILICA POOL

Location Rig up

Drilling and Remarks:

8" - 145Drig. 2350

RECORD

Cased in., ft.Sand Gas Oil Total Depth

PRODUCTION

1st 24 hrs. Nat. 1st 24 hrs. after shot Gas Cu. Ft.Dry Hole Abandoned

Date

MAY 7 1941 19 S. J. LEWIS Scout

Misc Small Maps

Cards

Tracing

France Map

Scarborough Map

Moody Map

Geological Dept.

Moody Plat Book

Map No. 46 Sec. 21 Twp. 19 R. 10WWell No. 2 NeidusSharon Drilling

Company

Contractor

COMPLETED

NE SW NE

Ft. from N. Line

990 Ft. from S. Line

Ft. from E. Line

990 Ft. from W. Line

SECTION PLAT

		o	

SILICA POOL

Location _____

Rig up _____

Drilling and Remarks:

*Cr 8320**5" @ 3116.**Li ans 2974**25 Bk to 3044-3065**500 acid**432 Gr.**Pump 21 P.T.*

RECORD

Cased _____ in., _____ ft.

Sand _____

Gas _____

Oil _____

Total Depth 3343

PRODUCTION

1st 24 hrs. Nat. _____

1st 24 hrs. after shot _____

Gas _____ Cu. Ft.

Dry Hole _____

Abandoned _____

Date

MAY 27 1941 19

S. J. LEWIS Scout

L.

f

Misc. Small Maps

Cards

Tracing

France Map

Scarborough Map

Moody Map

Geological Dept.

Moody Flat Book