

Rice

Map No. KANSAS Sec. 21 Twp. 19 R. 9W

#2 BYERS ~~2 Fourth Nat Bank~~ Farm


Well No. Magnolia Company

_____ Ft. from N. Line

330 Ft. from S. Line

_____ Ft. from E. Line

330 Ft. from W. Line

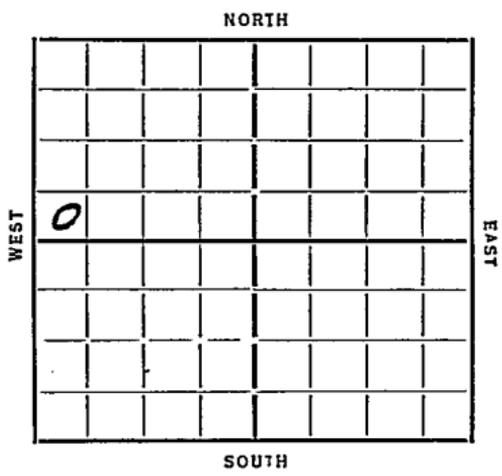

Date	REPORT
11/27	Location
12/6	12/13 — 12/21 — 12/27
1/3/35	1/19 — 1/17 — 1/24
1/31	2/7
2/14	Bldg Rig
2/21	Rgn Rte
2/28	102" 160 WOC
3/7	Blg 1950
3/14	" 2898 KC 2880
3/21	Sil 3224 6" 3224
	T1 3229 Rust
3/28	T1 3235 Rust 34 Bbls 4 hrs.
4/4	3238 T1 10 Bbls per hr 1000 acid
4/11	353 Bbls Reacidize
4/17	Silicious 3224 T1 3246 1000 acid 893 Bbls.

COMPLETED

Map No. 49 Sec. 21 Twp. 19 R. 9 W

Well No. 2-Fourth Nat'l Bank

Magnolia Company

Contractor

FIRST REPORTS SECTION PLAT

.....Ft. from N. Line

330 Ft. from S. Line

.....Ft. from E. Line

330 Ft. from W. Line

0			

Location

Rig up.....

Drilling and Remarks:

RECORD

Cased.....in.ft.

Sand.....

Gas.....

Oil.....

Total Depth.....

PRODUCTION

1st 24 hrs. Nat.....

1st 24 hrs. after shot.....

Gas.....Cu. Ft.

Dry Hole.....

Abandoned.....

Date

11-27-37 192

ORVAL MANNSCHRECK

Scout

Map No. 49 Sec. 21 Twp. 19 R. 9W

Well No. 2-Byers

Magnolia Company

Contractor

CORRECTION

..... Ft. from N. Line

330 Ft. from S. Line

..... Ft. from E. Line

330 Ft. from W. Line

CORRECTION

SECTION PLAT

Location.....

Rig up.....

Drilling and Remarks:

formerly Reported

#2-4th nat'l Bk

RECORD

Cased..... in., ft.

Sand.....

Gas.....

Oil.....

Total Depth.....

PRODUCTION

1st 24 hrs. Nat.....

1st 24 hrs. after shot.....

Gas..... Cu. Ft.

Dry Hole.....

Abandoned.....

Date

2-6-35 192.....

ORVAL MANNSCHRECK

Scout

Map No. 49 Sec. 21 Twp. 19 R. 9W

Well No. 2-Byers

Magnolia Pet Company

Contractor

COMPLETED

SECTION PLAT

0			

..... Ft. from N. Line

330 Ft. from S. Line

..... Ft. from E. Line

330 Ft. from W. Line,

RECORD

Location.....

Cased..... in., ft.

Rig up.....

Sand Siliceous 3224

Drilling and Remarks:

Gas.....

1070 and

Oil.....

Total Depth 3246

893 lbs

PRODUCTION

1st 24 hrs. Nat.....

1st 24 hrs. after shot.....

Gas..... Cu. Ft.

Dry Hole.....

Abandoned.....

Date

4-17-35 192.....

ORVAL MANNSCHRECK

Scout