


KANSAS

Rice  
21 19 90

Map No. \_\_\_\_\_ Sec. 21 Twp. 19 R. 90

Well No. 45-Byers  
Magnolia \_\_\_\_\_ Farm  
\_\_\_\_\_ Company

NORTH

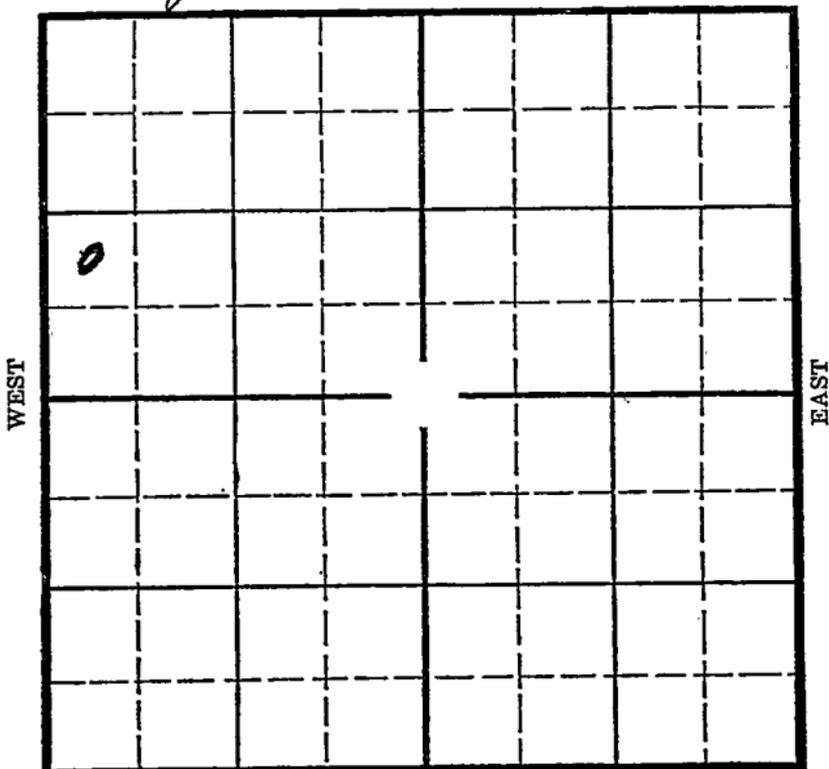

SOUTH

Location \_\_\_\_\_

Drilling Remarks \_\_\_\_\_

\_\_\_\_\_

\_\_\_\_\_

Rig Up \_\_\_\_\_

Drilling Remarks \_\_\_\_\_

\_\_\_\_\_

\_\_\_\_\_

RECORD

Cased \_\_\_\_\_ in. \_\_\_\_\_ ft.

Sand \_\_\_\_\_

Gas \_\_\_\_\_

Oil \_\_\_\_\_

Total Depth \_\_\_\_\_

PRODUCTION

1st 24 hrs. Nat. \_\_\_\_\_

1st 24 hrs. after shot \_\_\_\_\_

Gas \_\_\_\_\_ cu. ft. \_\_\_\_\_

Dry Hole \_\_\_\_\_

Abandoned \_\_\_\_\_

Rice

Map No. KANSAS Sec. 21 Twp. 19 R. 9W

Well No. 5 - Beeper Farm  
Magnolia Company


\_\_\_\_\_ Ft. from N. Line

990 Ft. from S. Line

\_\_\_\_\_ Ft. from E. Line

330 Ft. from W. Line

NORTH

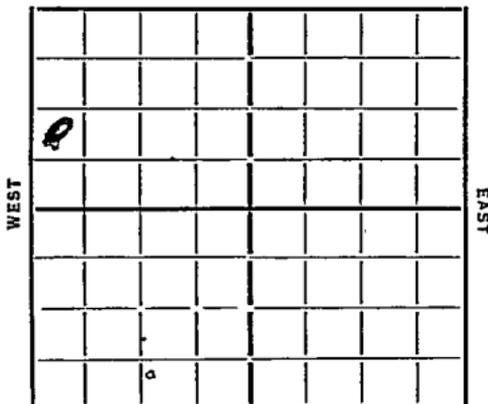

SOUTH

Elev. 1721

Date

REPORT

1935  
 6/19 Moving In  
 6/28 Dlg 1760  
 7/3 " 3225  
 7/11 Topeka 2470  
 All 3242 7" 3240  
 7/18 3256 H.F.F. P.B. 3254  
~~topeka~~ tubing  
 8/7 Top Siliceous lime  
 3242  
 T.D. 3256  
 P.B. to 3254  
 398 oil  
 740 water

COMPLETED

Map No. 49 Sec. 21 Twp. 19 R. 9W

Well No. 5-Beyers

Magnolia Company

Contractor

### FIRST REPORTS

### SECTION PLAT

..... Ft. from N. Line

990 Ft. from S. Line

..... Ft. from E. Line

330 Ft. from W. Line

0			

Location.....

Rig up.....

Drilling and Remarks:

*Moving in*

### RECORD

Cased.....in., .....ft.

Sand.....

Gas.....

Oil.....

Total Depth.....

### PRODUCTION

1st 24 hrs. Nat.....

1st 24 hrs. after shot.....

Gas..... Cu. Ft.

Dry Hole.....

Abandoned.....

Date

6-19-30 192.....

**ORVAL MANNSCHECK**

Scout

Map No. 49 Sec. 21 Twp. 19 R. 9W

Well No. 5-Beyer

Magnolia Pet Company

Contractor

**COMPLETED**

**SECTION PLAT**

.....Ft. from N. Line

990 Ft. from S. Line

.....Ft. from E. Line

330 Ft. from W. Line

0			

Location.....

Rig up.....

Drilling and Remarks:

P.B. 3254

398 oil

740 water

**RECORD**

Cased.....in.; .....ft.

Sand oil 3242

Gas.....

Oil.....

Total Depth 3256

**PRODUCTION**

1st 24 hrs. Nat.....

1st 24 hrs. after shot.....

Gas.....Cu. Ft.

Dry Hole.....

Abandoned.....

Date

8-7-35

192

**ORVAL MANNSCHECK**

Scout