

Rice

Map No. KANSA Sec. 21 Twp. 19 R. 9 W

Well No. 5 Link Farm


Phillips Pet. Company

330 Ft. from N. Line

_____ Ft. from S. Line

_____ Ft. from E. Line

990 Ft. from W. Line

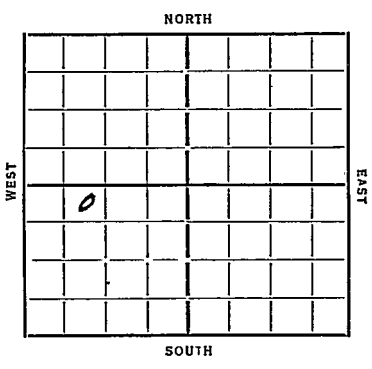

Date 7/35 REPORT

4/17 Location

4/26 12" 217 WOC

5/2 Alg 7515

5/9 3417 Rust ..

5/16 Sil 3213 7" 3214

Oil 3222 T7 3250

2100' oil

5/23 366 Bbls Nat 1000 acid

5/29 _____

6/5 Silicous 3213 T7 3250

1000 acid 322 Bbls.

COMPLETED

Map No. 49 Sec. 21 Twp. 19 R. 9W

Well No. 5-Link

Phillips pet Company
Contractor

FIRST REPORTS

SECTION PLAT

330 Ft. from N. Line
..... Ft. from S. Line
..... Ft. from E. Line
990 Ft. from W. Line

Location
Rig up
Drilling and Remarks:

RECORD

Cased.....in.,ft.
Sand.....
Gas.....
Oil.....
Total Depth.....

PRODUCTION

1st 24 hrs. Nat.....
1st 24 hrs. after shot.....
Gas.....Cu. Ft.
Dry Hole.....
Abandoned.....

Date

4-17-35 192

ORVAL MANNSCHRECK

Scout

Map No. 49 Sec. 21 Twp. 19 R. 9W

Well No. 5-Link

Phillips Petroleum Company

Contractor

SECTION PLAT

SECTION PLAT

0			

330 Ft. from N. Line

..... Ft. from S. Line

..... Ft. from E. Line

990 Ft. from W. Line

Location

Rig up

Drilling and Remarks:

1000 and

322 ppb

RECORD

Cased..... in., ft.


Gas.....

Oil.....

Total Depth 3250

PRODUCTION

1st 24 hrs. Nat.....

1st 24 hrs. after shot.....

Gas..... Cu. Ft.

Dry Hole.....

Abandoned.....

Date

ORVAL MANNSCHRECK

5-5-35 192

Scout