

KANSAS

 RiceSection 21 Township 19S Range 9WWell No. #5 MeyersCompany Cities Service

	0						

NORTH

WEST

EAST

SOUTH

Sec. 21 Twp. 19 R. 9-W ✓

Well No. #5 Meyers Farm

Cities Service Company

Chase Pool


 Ft. from N. Line

330 Ft. from S. Line

 Ft. from E. Line

990 Ft. from W. Line

SE SW SW

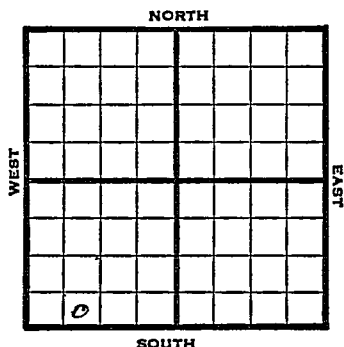

1949	Elev 1717' REPORT
10/5	Location
10/12	"
10/19	"
10/26	8" @ 264'
11/1	Drlg. 2893'
11/9	Lansing 2896' Arbuckle 3210'
	TD 3214'
	5" @ 3211'
11/16	TD 3215'
	Arb. 3210'
	5 @ 3211'
	2000 acid
	Pump 26 Oil / 12½ W Pot
	42° Gr.
	Comp
	COMPLETED

Map No. _____ Sec. 21 Twp. 19 R. 9W

Well No. 5 Meyers

Cities Service Company

Contractor

SE SW SW

FIRST REPORT
SECTION PLAT

_____ Ft. from N. Line

330 _____ Ft. from S. Line

_____ Ft. from E. Line

990 _____ Ft. from W. Line

Rice County

Location X

Rig up

Drilling and Remarks:

RECORD

Cased _____ in., _____ ft.

Sand _____

Gas _____

Oil _____

Total Depth _____

PRODUCTION

1st 24 hrs. Nat. _____

1st 24 hrs. after shot _____

Gas _____ Cu. Ft.

Dry Hole _____

Abandoned _____

Date

OCT 5 1949 19

S. J. LEWIS Scout

Map No. _____ Sec. 21 Twp. 19 R. 9W

Well No. 5 Meyers

Cities Service

Company

COMPLETE

Contractor

SE SW SW


E11712
SECTION PLAT

_____ Ft. from N. Line

330 Ft. from S. Line

_____ Ft. from E. Line

990 Ft. from W. Line

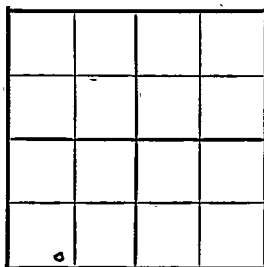

Rice County

Location _____

Rig up _____

Drilling and Remarks:


RECORD

Cased _____ in., _____ ft.

Sand _____

Gas _____

Oil _____

Total Depth 3215

PRODUCTION

1st 24 hrs. Nat. _____

1st 24 hrs. after shot _____

Gas _____ Cu. Ft.

Dry Hole _____

Abandoned _____

Date

NOV 16 1949 19

S. J. LEWIS Scout