

# KANSAS


Rice

FORM 51 5M 4-41 PETROL

Section 21 Township 19 Range 9-W

Well No. #1 Ramiller

Company Lauck & Moncrief

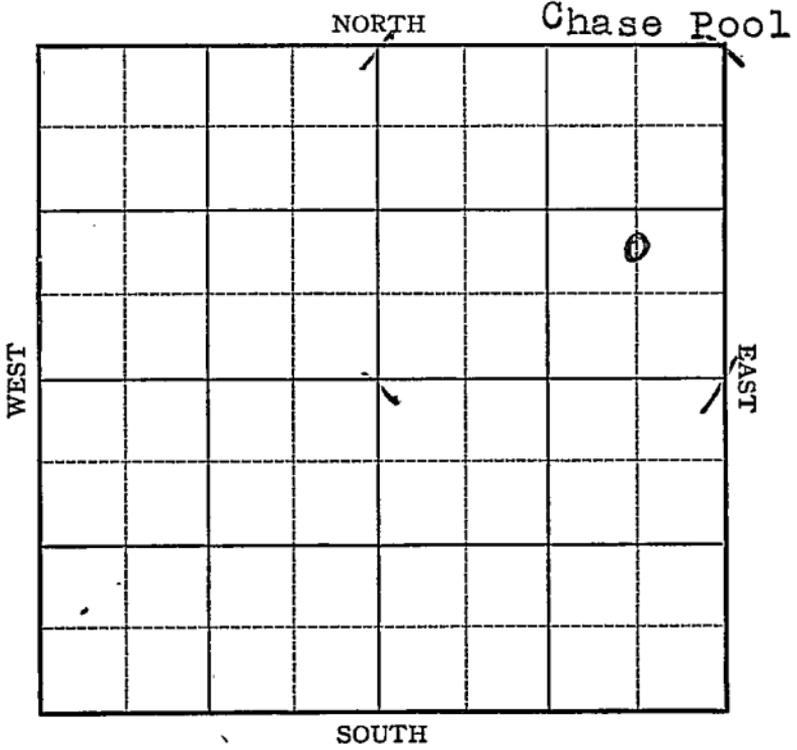

Sec. 21 Twp. 19 R. 9-W

Well No. #1 Ramiller Farm

Lauck & Moncrief Company

(Chase)


           Ft. from N. Line

990 Ft. from S. Line

660 Ft. from E. Line

           Ft. from W. Line

*Elv. 1704*

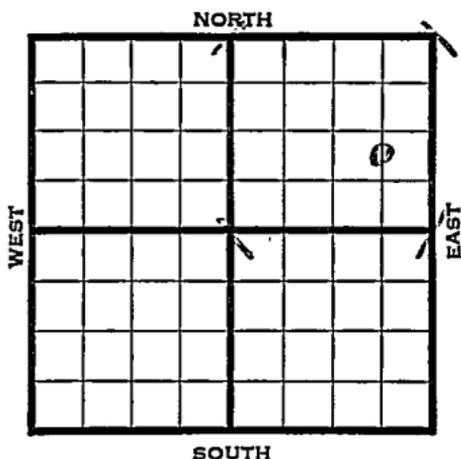

1942

REPORT

6/3	10" - 164'
	Drlg. 1400'
6/14	Lans. 2873' Arb. <sup>3212'</sup> <del>3216-19'</del> T.D.
	5" - <sup>3213'</sup> <del>3217'</del> RUST.
6/17	Arb. 3212' (Corrected) 5" - 3213'
	T.D. 3244' Shot 20 qts. 3232-42'
6/24	500 acid. Swab 3-3/4 oil per hour.
7/1	" " " "
7/8	Arb. 3212'
	5" - 3213'
	T.D. 3244'
	Shot 20 qts. 3232-42'
	500 acid.
	Potential 271 bbls., pump.
	44.7 Gravity

**COMPLETED**

Map No. 49 Sec. 21 Twp. 19 R. 9W

Well No. 1 Ramiller

Lauck & Moncrief Company

**FIRST REPORT**

Contractor

C N L S E N E


\_\_\_\_\_ Ft. from N. Line

990 Ft. from S. Line

660 Ft. from E. Line

\_\_\_\_\_ Ft. from W. Line

SECTION PLAT

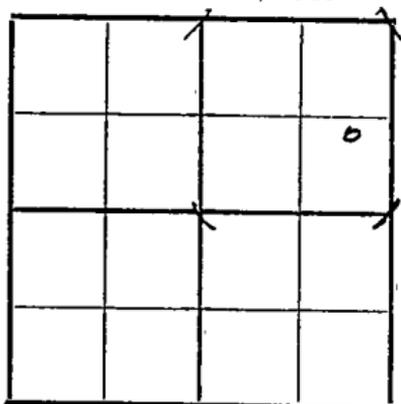

CHASE POOL

Location \_\_\_\_\_

Rig up \_\_\_\_\_

Drilling and Remarks:

10" - 164'

Drlg. 1400'

RECORD

Cased \_\_\_\_\_ in., \_\_\_\_\_ ft.

Sand \_\_\_\_\_

Gas \_\_\_\_\_

Oil \_\_\_\_\_

Total Depth \_\_\_\_\_

PRODUCTION

1st 24 hrs. Nat. \_\_\_\_\_

1st 24 hrs. after shot \_\_\_\_\_

Gas \_\_\_\_\_ Cu. Ft.

Dry Hole \_\_\_\_\_

Abandoned \_\_\_\_\_

Date

JUN 3

1942

19

S. J. LEWIS Scout

