

Rice


Form 51-5M-5-34-Palace

Map No. *KANSAS* Sec. *21* Twp. *19* R. *9W*

Well No. *3 Link* Farm

Phillips Pet. Company

NORTH

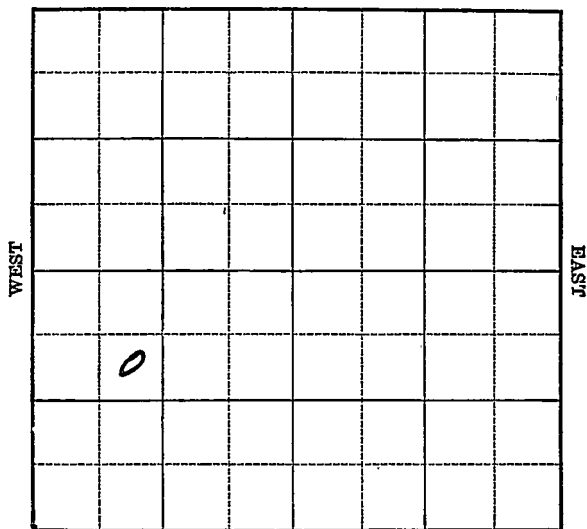

SOUTH

Location

Drilling Remarks

Rig Up

Drilling Remarks

RECORD

Cased _____ in. _____ ft.

Sand _____

Gas _____

Oil _____

Total Depth _____

PRODUCTION

1st 24 hrs. Nat. _____


1st 24 hrs. after shot _____

Gas _____ cu. ft.

Dry Hole _____

Abandoned _____

990 Ft. from W. Line

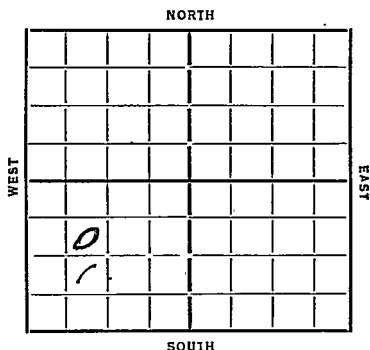

Date /

REPORT

11/21	M.O. Y.
11/28	Rot. Rig
12/6	Rgn Rot.
12/13	Oily 1702 10" 241
12/21	" 2853
12/27	Siliceous 3201 7' 3201
	T7 3204 N.O. Rust
1/3/35	Oil 3203-06 T7 3220
	500' oil
1/10	95 Bbls, 24 hrs. acidize
1/17	— 1/24 —
1/31	R N to Deepen
2/7	T7 3234 Swab 122 Bbls
	8 hrs Swab down
2/13	Siliceous 3201 T7 3234
	775 Bbls

COMPLETED

KANSAS

Map No. 49 Sec. 21 Twp. 19 R. 9WWell No. 3-LinkPhillip Put Company

Contractor

SECTION PLAT

2			
0			

FIRST REPORTS

990 Ft. from N. Line

Ft. from S. Line

Ft. from E. Line

990 Ft. from W. Line

Location

Rig up

Drilling and Remarks:

RECORD

Cased in., ft.

Sand

Gas

Oil

Total Depth

PRODUCTION

1st 24 hrs. Nat.

1st 24 hrs. after shot

Gas Cu. Ft.

Dry Hole

Abandoned

Date

11-21-37 192ORVAL MANNSCHRECK
Scout

KANSAS

Map No. 49 Sec. 21 Twp. 19 R. 9WWell No. 3-LinkPhillips Pet Company

Contractor

COMPLETED

SECTION PLAT

990 Ft. from N. Line

Ft. from S. Line

Ft. from E. Line

990 Ft. from W. Line

Location

Rig up

Drilling and Remarks:

775 bbl

RECORD

Cased in, ft.

Sand siliceous 3201

Gas

Oil

Total Depth 3234

PRODUCTION

1st 24 hrs. Nat.

1st 24 hrs. after shot

Gas Cu. Ft.

Dry Hole

Abandoned

Date

ORVAL MANNSCHRECK

2-13-35 192 Scout