


Map No. **KANSAS** Sec. **21** Twp. **19** R. **9W**
 Well No. **6-Link** Farm
Phillips Pet Company

NORTH

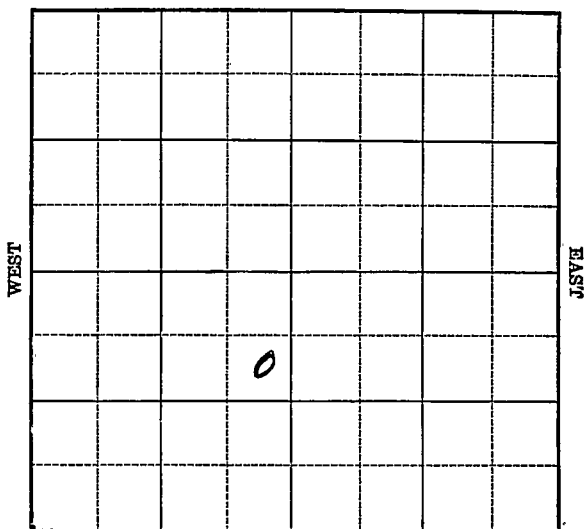

SOUTH

Location

Drilling Remarks

Rig Up

Drilling Remarks

RECORD

Cased _____ in. _____ ft.

Sand _____

Gas _____

Oil _____

Total Depth _____

PRODUCTION

1st 24 hrs. Nat. _____

1st 24 hrs. after shot _____

Gas _____ cu. ft.

Dry Hole _____

Abandoned _____

Rice

Map No. KANSAS Sec. 21 Twp. 19 R. 9W
Well No. 6- Link Farm
Phillips Pst. Company

NORTH

WEST

EAST

SOUTH

 Ft. from N. Line

990 Ft. from S. Line

330 Ft. from E. Line

 Ft. from W. Line

Date	REPORT
1935	
5/8	Rot Rig
5/16	delg 1600 13" 219
5/23	" 2940
5/29	del 3252 T 7 3254 Run 7"
6/6	50 3284 3300 3 Revph 57
6/13	delg 3305
6/20	" 3337
6/28	14FW 3406 delg
7/3	delg 3439
7/11	~~7/18~~ — 8/8 — 8/15 —
8/22	
8/29	delg 3620
9/6	~~10/3~~ —
10/9	del 3253
	T 7 3620
	To Be used as a salt water disposal well.
	ABANDONED

KANSAS

Map No. 49 Sec. 21 Twp. 19 R. 9WWell No. 6 - LinkPhillips Pet Company

Contractor

FIRST REPORTS

SECTION PLAT

Ft. from N. Line

990 Ft. from S. Line330 Ft. from E. Line

Ft. from W. Line

Location

Rig up

Drilling and Remarks:

Rot Rig

RECORD

Cased.....in., ...ft.

Sand.....

Gas.....

Oil.....

Total Depth.....

PRODUCTION

1st 24 hrs. Nat.....

1st 24 hrs. after shot.....

Gas.....Cu. Ft.

Dry Hole.....

Abandoned.....

Date

5-8-35 192

ORVAL MANNSCHRECK

Scout

Map No. 49 Sec. 21 Twp. 19 R. 9Well No. 6-LinkPhillips Company

Contractor

ABANDONED

SECTION PLAT

Ft. from N. Line

990 Ft. from S. Line330 Ft. from E. Line

Ft. from W. Line

	0		

Location

Rig up

Drilling and Remarks:

To be used
as a salt
water disposal
well.

RECORD

Cased _____ in. _____ ft.

Sand sil 3253

Gas _____

Oil _____

Total Depth 3620

PRODUCTION

1st 24 hrs. Nat. _____

1st 24 hrs. after shot _____

Gas _____ Cu. Ft.

Dry Hole _____

Abandoned _____

Date

10-9-35 192

ORVAL MANNSCHRECK

Scout