


Rice

Form 51-5M-5-34-Palace

Map No. **KANSAS** Sec. 21 Twp. 19 R. 9W

Well No. 1 Meyer Farm
Empire Oil Company

NORTH

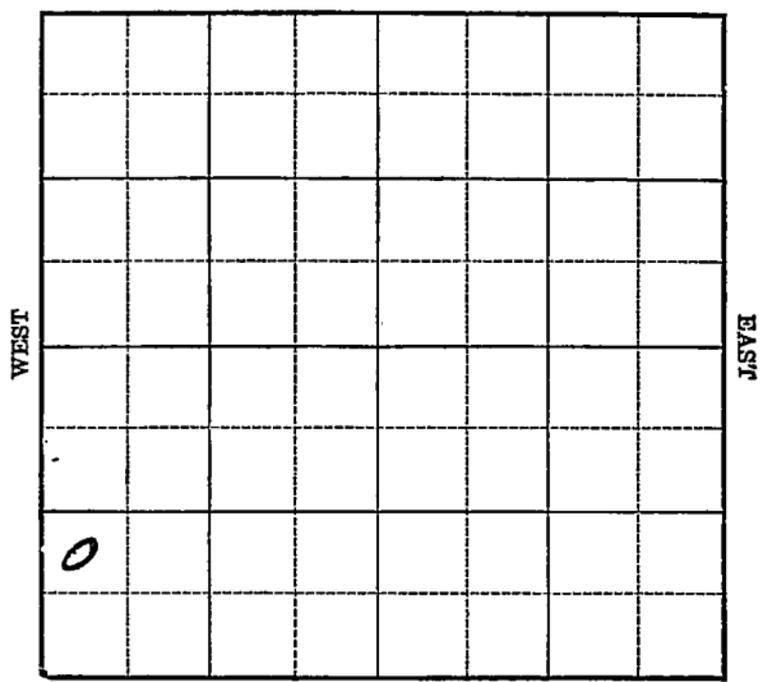

SOUTH

Location _____

Drilling Remarks _____

RECORD

Cased _____ in. _____ ft.

Sand _____

Gas _____

Oil _____

Total Depth _____

Rig Up _____

Drilling Remarks _____

PRODUCTION

1st 24 hrs. Nat. _____

1st 24 hrs. after shot _____

Gas _____ cu. ft.

Dry Hole _____


Abandoned _____

Rice

Map No. KANSAS Sec. 21 Twp. 19 R. 9W

Well No. 1 Meyers Farm
Empire Oil Company

_____ Ft. from N. Line
990 Ft. from S. Line
_____ Ft. from E. Line
330 Ft. from W. Line

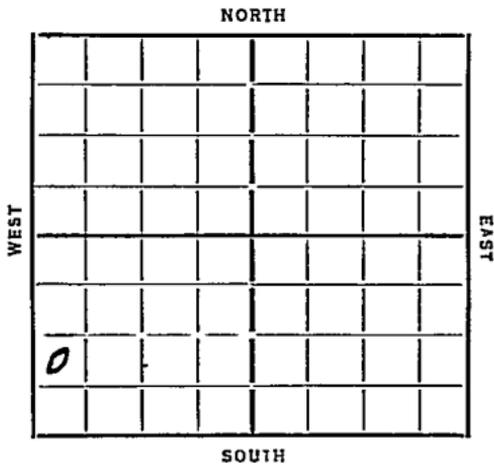

Date 1954 REPORT

10/17 Bldg.
10/25 _____
11/1 Rgn up 20" 161
11/8 Dlg 250 15" 461
11/15 " 1260 12" 1161
11/22 " 1890
11/28 A.G. 2020 10" 1905
WR 10" 2067
12/6 10" 2267 K.C. 2889 8" 2900
Dlg 2924
12/13 Cong. 3192 Siliceous 3196 R.O.
3198 TD Cem 6"
12/21 TD 3207 3000' oil Tubing
12/26 Siliceous 3196 TD 3287
1270 Bldg.

COMPLETED

Map No. 49 Sec. 21 Twp. 19 R. 9W

Well No. 1-Meyers

Empire Oil Company

Contractor

FIRST REPORT SECTION PLAT

..... Ft. from N. Line

990 Ft. from S. Line

..... Ft. from E. Line

330 Ft. from W. Line

Location.....

Rig up.....

Drilling and Remarks:

Blsg

RECORD

Cased..... in., ft.

Sand.....

Gas.....

Oil.....

Total Depth.....

PRODUCTION

1st 24 hrs. Natural.....

1st 24 hrs. after shot.....

Gas..... Cu. Ft.

Dry Hole.....

Abandoned.....

Date

10-17-34 192

CRIVEL MANSCHRECK

Scout

Map No. 49 Sec. 21 Twp. 19 R. 9W

Well No. 1-Meyers

Empire Oil Company

Contractor

COMPLETED

SECTION PLAT

0			

.....Ft. from N. Line

990 Ft. from S. Line

.....Ft. from E. Line

330 Ft. from W. Line

Location.....

Rig up.....

Drilling and Remarks:

1270 lbs

RECORD

Cased.....in.,ft.

Sand: siliceous 3196

Gas.....

Oil.....

Total Depth 3207

PRODUCTION

1st 24 hrs. Nat.....

1st 24 hrs. after shot.....

Gas.....Cu. Ft.

Dry Hole.....

Abandoned.....

Date

12-26-34 192

ORVAL MANNSCHRECK

Scout