

Rice

KANSAS ✓

Sec. 21 Twp. 19 R. 9W

Well No. #1 Murphy Farm

Lewis Drlg. Company


Chase Pool (Lewis Drlg., Cont.)

990' Ft. from N. Line

_____ Ft. from S. Line

990' Ft. from E. Line

_____ Ft. from W. Line

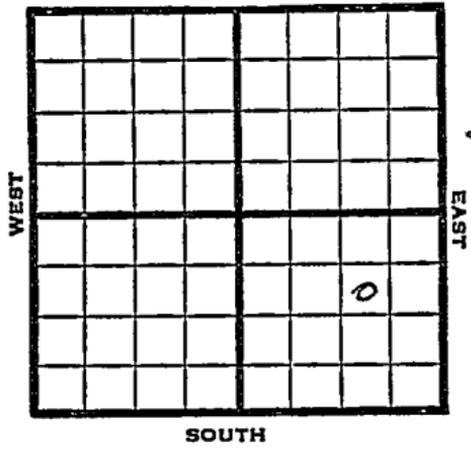

SW NE SE

1949 Elev. 1699' REPORT

9/21 8" @ 184'
Anhy 333'
TD 3229'
5" @ 3226'
Lans. 2883'
Arb. 3219'

9/28 TD 3265' Wgr.
Plug 3150'
48 shots 2925'
33 SSO

9/28
10.5 Lans. 2883'
Arb. 3219'
TD 3265'

ABANDONED

Map No. _____ Sec. 21 Twp. 19 R. 9W

Well No. 1 Murphy

Lewis Drlg. _____ Company

Lewis Drlg. _____ Contractor

SW NE SE

FIRST REPORT
SECTION PLAT

990 _____ Ft. from N. Line

_____ Ft. from S. Line

990 _____ Ft. from E. Line

_____ Ft. from W. Line

Rice County

RECORD

Location _____

Cased _____ in., _____ ft.

Rig up _____

Sand _____

Drilling and Remarks:

Gas _____

8" @ 184

Oil _____

Anhy 333

Total Depth _____

TD 3229

PRODUCTION

5" @ 3226

1st 24 hrs. Nat. _____

Lans. 2883

1st 24 hrs. after shot _____

Arb. 3219

Gas _____ Cu. Ft.

Dry Hole _____

Abandoned _____

Date

SEP 21 1940 19

S. J. LEWIS Scout

Map No. _____ Sec. 21 Twp. 19 R. 9W

Well No. 1 Murphy

Lewis Drl. Co. Company

ABANDONED

Contractor

SW NE SE

E 11/16 88
SECTION PLAT

990 Ft. from N. Line

_____ Ft. from S. Line

990 Ft. from E. Line

_____ Ft. from W. Line

			0

Rice County

Location _____

Rig up _____

Drilling and Remarks:

Line 2883

Q 28218

RECORD

Cased _____ in. _____ ft.

Sand _____

Gas _____

Oil _____

Total Depth *3265*

PRODUCTION

1st 24 hrs. Nat. _____

1st 24 hrs. after shot _____

Gas _____ Cu. Ft.

Dry Hole _____

Abandoned _____

Date

OCT 5 1949 19

S. J. LEWIS Scout