


Section 21 Township 19 Range 9-W

Well No. #1 Murphy

Company Lauck & Moncrief

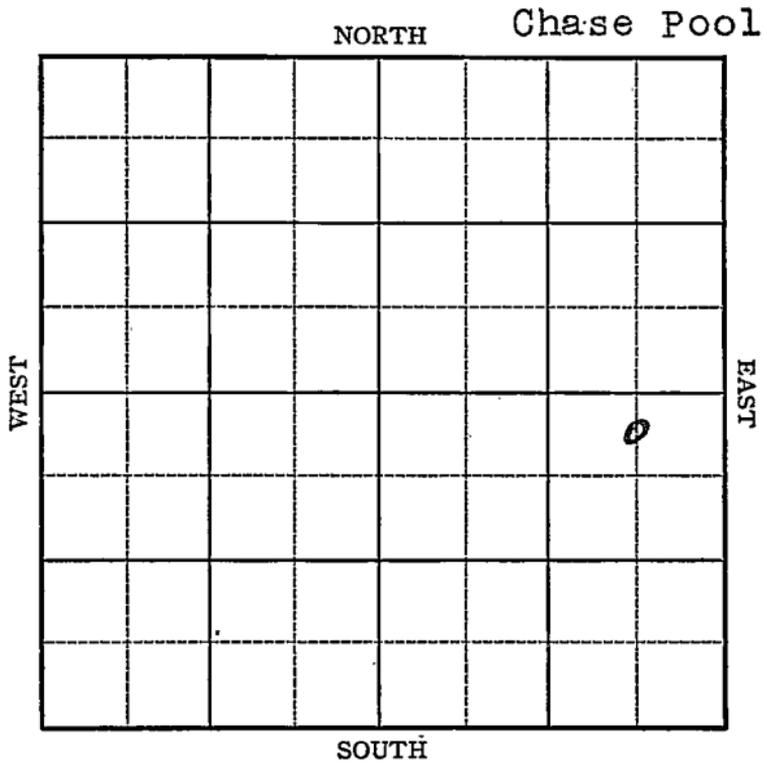

Sec. 21 Twp. 19 R. 9-W

Well No. #1 Murphy Farm

Lauck & Moncrief Company


(Chase)

330 Ft. from N. Line

_____ Ft. from S. Line

660 Ft. from E. Line

_____ Ft. from W. Line

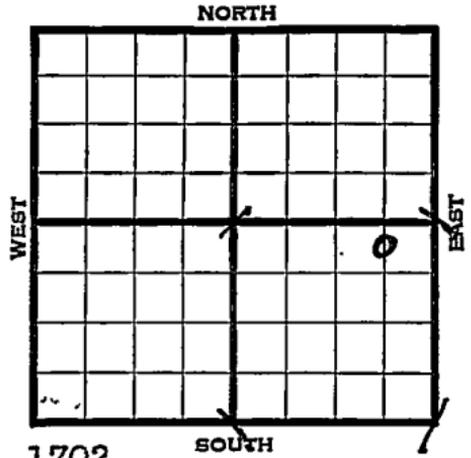

Elev. 1702


1942.	REPORT
3/4	Location
3/11	Rotary.
3/19	10" - 134' Drlg. 1410'
3/26	Lans. 2873' Arb. 3216-24' T.D.
	5" - 3216' RUST.
4/2	T.D. 3249' 500 acid. Swab 60 oil.
4/8	" " "
4/15	Arb. 3216'
	5" - 3216'
	T.D. 3249'
	1500 acid.
	Potential 300 bbls., pump.
	43.4 Gravity
	COMPLETED

Rice

KANSASMap No. 49 Sec. 21 Twp. 19 R. 9WWell No. 1 MurphyLauck & Moncrief Company**FIRST REPORT** Contractor

C NL NE SE

SECTION PLAT

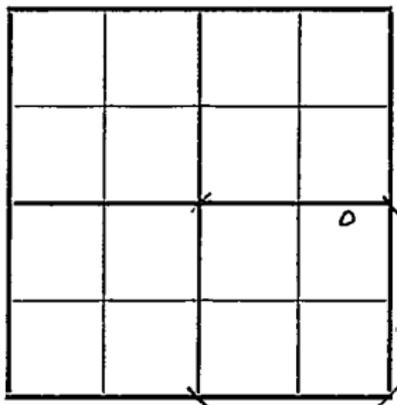330 Ft. from N. Line Ft. from S. Line660 Ft. from E. Line Ft. from W. Line

CHASE POOL

RECORD

Location XXCased in., ft.Rig up Sand

Drilling and Remarks:

Gas Oil Total Depth

PRODUCTION

1st 24 hrs. Nat. 1st 24 hrs. after shot Gas Cu. Ft.Dry Hole Abandoned

Date

MAR 4 1942 19S. J. LEWIS Scout

KANSAS

Map No. 49 Rice Sec. 21 Twp. 19 R. 9WWell No. 1 MurphyLauck & Monerief CompanyCOMPLETED Contractor

C NL NE SE

SECTION PLAT

330 Ft. from N. Line

_____ Ft. from S. Line

660 Ft. from E. Line

_____ Ft. from W. Line

			o

CHASE POOL

Location _____

Rig up _____

Drilling and Remarks:

*Ar 3216**5" @ 3216**1500 acid**Pump. 300 P.S.**43 1/2 hr*

RECORD

Cased _____ in., _____ ft.

Sand _____

Gas _____

Oil _____

Total Depth 3249

PRODUCTION

1st 24 hrs. Nat. _____

1st 24 hrs. after shot _____

Gas _____ Cu. Ft.

Dry Hole: _____

Abandoned _____

Date

APR 15 1942 19

S. J. LEWIS Scout