

Sec. 21 **KANSAS** Twp. 19 Rice R. 9W

Well No. #2 Ramiler Farm
D.R. Lauch Company

Chase Pool


990 Ft. from N. Line

_____ Ft. from S. Line

330 Ft. from E. Line

_____ Ft. from W. Line

SE NE NE

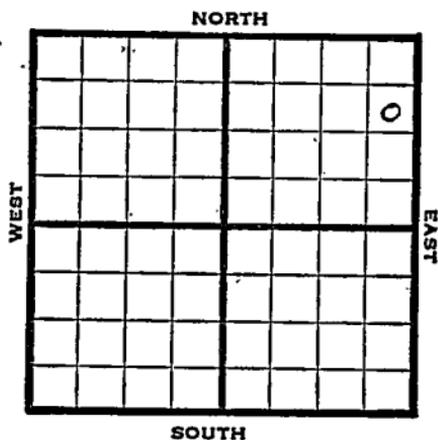

FORM 51 10M 8-47

KANSAS Rice


Section 21 Township 19 Range 9W

Well No. #2 Ramiler

Company D. R. Lauch

Chase Pool

NORTH

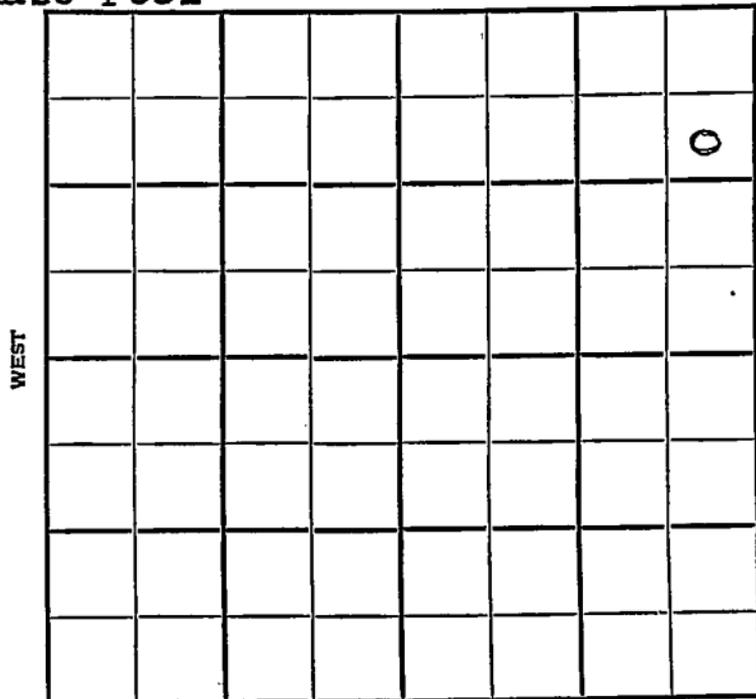

SOUTH

Map No. _____ Sec. 21 Twp. 19 R. 9W

Well No. 2 Remiler

D. R. Lauch Company

FIRST REPORT Contractor

SE NE NE

SECTION PLAT

990 Ft. from N. Line

_____ Ft. from S. Line

330 Ft. from E. Line

_____ Ft. from W. Line

			o

Rice County

Location _____

Rig up _____

Drilling and Remarks:

Anhy 320

10" @ 140

drlg. 3102

RECORD

Cased _____ in., _____ ft.

Sand _____

Gas _____

Oil _____

Total Depth _____

PRODUCTION

1st 24 hrs. Nat. _____

1st 24 hrs. after shot _____

Gas _____ Cu. Ft.

Dry Hole _____

Abandoned _____

Date

OCT 29 1947

19

S. J. LEWIS

Scout

Map No. 119 Sec. 21 Twp. 19 R. 9W

Well No. 2 Ramiler

D. R. Lauch Company

ABANDONED

Contractor

SE NE NE

E 11696
SECTION PLAT

990 Ft. from N. Line

_____ Ft. from S. Line

330 Ft. from E. Line

_____ Ft. from W. Line

			o

Rice County

Location _____

Rig up _____

Drilling and Remarks:

Dr 8219
5" @ 8219

RECORD

Cased _____ in., _____ ft.

Sand _____

Gas _____

Oil _____

Total Depth * *8253*

PRODUCTION

1st 24 hrs. Nat. _____

1st 24 hrs. after shot _____

Gas _____ Cu. Ft.

Dry Hole _____

Abandoned _____

Date

NOV 19 1947

S. J. LEWIS

Scout