

Form 51-5M-11-31-Palace
Map No. _____ Sec. 21 Twp. 19 R. 9W

Well No. 2 Beyer Farm
Smith & Ash Company

NORTH

[illegible]

SOUTH

Rig Up-----
Drilling Remarks

PRODUCTION

1st 24 hrs. Nat. _____

1st 24 hrs. after shot _____

Gas _____ cu. ft. _____

Dry Hole _____

Abandoned _____

Rice

Map No. KANSAS Sec. 21 Twp. 19 R. 9W


Well No. 2 Beyer Farm
Smith & Ash Company

330 Ft. from N. Line

 Ft. from S. Line

990 Ft. from E. Line

 Ft. from W. Line

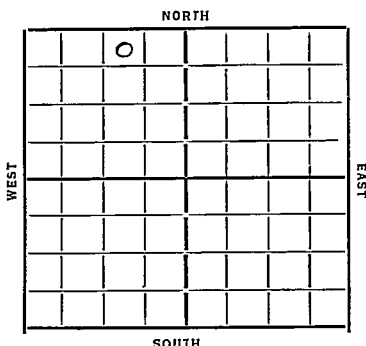

Date
1924

REPORT

3/4 Location
3/15 — 3/22 — 3/29 —
4/5 — 4/12 — 4/19 —
4/26 — 5/3 —
5/10 Rig
5/18 —
5/25 Rign
5/31 Oly 415
6/7 " 1385 12" 1289
6/14 " 1975
6/21 sand 2000-15
7 M Hrs 10" 1988 2285 R
10 "
6/28 10" 2256 Oly 2870
7/5 8" 3134 T 3207
7/12 HFW 3295-3300 T 330.1 SD
7/18 Siliceous 3295 T 3302 D r A

ABANDONED

Map No. 49 Sec. 21 Twp. 19 R. 9W

Well No. 2-Beyer

Smith & Ash Company

Contractor

77W77E77N
FIRST REPORTS

SECTION PLAT

	0		

330 Ft. from N. Line

_____ Ft. from S. Line

990 Ft. from E. Line

_____ Ft. from W. Line

Location ☒

Rig up _____

Drilling and Remarks:

RECORD

Cased _____ in., _____ ft.

Sand _____

Gas _____

Oil _____

Total Depth _____

PRODUCTION

1st 24 hrs. Nat. _____

1st 24 hrs. after shot _____

Gas _____ Cu. Ft.

Dry Hole _____

Abandoned _____

Date

3-7-34 1934 O. Manschreck Scout

KAR

Map No. 49 Sec. 21 Twp. 19 R. 9W

Well No. 2-Beyer

Smith & Ash Company

Contractor

ABANDONED

SECTION PLAT

	0		

330 Ft. from N. Line

_____ Ft. from S. Line

990 Ft. from E. Line

_____ Ft. from W. Line

Location _____

Rig up _____

Drilling and Remarks:

silicious 3295

10 & A

RECORD

Cased _____ in., _____ ft.

Sand _____

Gas _____

Oil _____

Total Depth 3302

PRODUCTION

1st 24 hrs. Nat. _____

1st 24 hrs. after shot _____

Gas _____ Cu. Ft.

Dry Hole _____

Abandoned _____

Date

7-18-34 19

ORVAL MANNSCHRECK

Scout