



Map No. KANSAS Sec. 21 Twp. 19 R. 9<sup>w</sup>

Well No. 1 - Bowers Farm


Nuth Bros Company

330 Ft. from N. Line

\_\_\_\_\_ Ft. from S. Line

330 Ft. from E. Line

\_\_\_\_\_ Ft. from W. Line

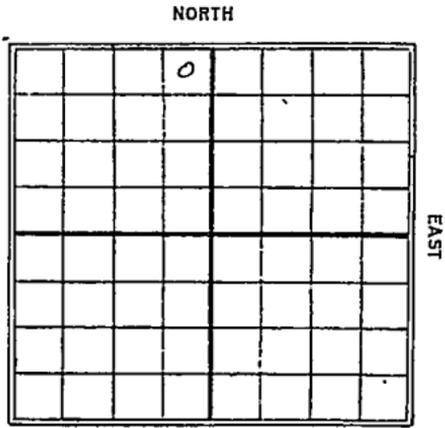

1930 SW<sup>1</sup>/<sub>4</sub> Sec. 17-19-9<sup>w</sup> <sup>our lease-</sup>

Date	REPORT
10/8	Polg
10/15	Polg
10/22	Spud 170'
10/29	Drily 615'
11/5	Run 12 1/2" - 1178'
11/12	Drily 1670'
11/19	" 1915'
11/25	Show gas 2000-2002 T.D. G.P. 10"
12/3	10" - 1998 T.D. 2005
	Mudding off gas
12/16	Drily 2268
12/17	" 2690
12/23	1 bbl oil day 2915-27 Drily 2945
12/30	6 bbl water at 3060 TD 3070' Clay out
1931	
1/7	SD 3085
1/14	—
1/21	—

1/28 T.D. 3085' Cly out  
2/4 6"-3148  
Base Kans. City lime 3151  
T.D. 3174' Cly out  
2/9 Top Silicious lime 3213  
T.D. 3244  
swab 200 bbl 9 hrs  
Had 3000' oil when they  
started swabbing and  
could not lower  
below 1200' - Gravity 44°  
Will not deepen at once  
No water - Very little gas  
2/10 Top pay 3213 T.D. 3244  
Filled up 3000' - Swabbed  
250 bbls. 7 hrs. - 1000 ft. off  
bottom • Swab 16 bbls per hour  
1000' off bottom after head -  
swabbed off - Gravity 45 plus.  
(Telegram)  
2/18 Sand 3213-44  
T.D. 3244  
swab 300 bbl oil  
Comp.  
1931 OWDD  
9/23 Old T.D. 3244  
swab 250 bbl oil and  
40 bbl water Sept 19  
swab 196 bbl oil &  
20 bbl water Sept 20  
swab 178 bbl oil and  
20 bbl water Sept 21  
May deepen  
9/30 Sand 3213-44 Comp  
T.D. 3244  
swab 168 bbl - 10% water

Map No. KANSAS Sec. 21 Twp. 19 R. 9W

49  
Well No. 1 Boyess

Math. Boyess Company

Contractor

**SECTION PLAT**

320 Ft. from N. Line

..... Ft. from S. Line

330 Ft. from E. Line

..... Ft. from W. Line

	0		

**FIRST REPORTS**

Location.....

Rig up.....

Drilling and Remarks:

ROG

**RECORD**

Cased..... in., ..... ft.

Sand.....

Gas.....

Oil.....

Total Depth.....

**PRODUCTION**

1st 24 hrs. Nat.....

1st 24 hrs. after shot.....

Gas..... Cu. Ft.

Dry Hole.....

Abandoned.....

Date

OCT 8 1930

S. J. LEWIS Scout

Returned \_\_\_\_\_  
Cards \_\_\_\_\_  
Tracing *CKK* \_\_\_\_\_  
France Map *X* \_\_\_\_\_  
Scarborough Map \_\_\_\_\_ *X*  
Moody Map *X* \_\_\_\_\_  
Scarborough Plat Book \_\_\_\_\_  
Moody Plat Book \_\_\_\_\_

*Rice*  
 Map No. KANSAS Sec. 21 Twp. 19 R. 9W

49  
 Well No. 1 Beyers

M. H. Biss Company

Contractor

## SECTION PLAT .

330 Ft. from N. Line

..... Ft. from S. Line

330 Ft. from E. Line

..... Ft. from W. Line

	0		

COMPLETED

Location.....

Rig up.....

Drilling and Remarks:

*swab 300 ft.*

## RECORD

Cased.....in., .....ft.

Sand 3213 - 44

Gas.....

Oil.....

Total Depth 3244

## PRODUCTION

1st 24 hrs. Nat.....

1st 24 hrs. after shot.....

Gas.....Cu. Ft.

Dry Hole.....

Abandoned.....

Date

FEB 18 1931

192

S. J. LEWIS Scout

*Handwritten notes:*  
I will  
I will

Returned	.....
Cards	.....
Tracing	.....
France Map	.....
Scarborough Map	.....
Moody Map	.....
Scarborough Plat Book	.....
Moody Plat Book	.....

*Rice*

Map No. **KANSAS** Sec. *21* Twp. *19* R. *9* <sup>W</sup>

Well No. *1* *Beyers*

*Much Bros* Company

Contractor

**FIRST REPORTS**

**SECTION PLAT**

*330* Ft. from N. Line

..... Ft. from S. Line

*330* Ft. from E. Line

..... Ft. from W. Line

	●		

*Our lease SW<sup>4</sup> of 17.*  
*"OWDD"*

Location.....

**RECORD**

Rig up *Old JD 3244*

Cased..... in., ..... ft.

Drilling and Remarks:

Sand *3213-44*

Gas.....

*9/19/31. Swab 250 lbs Oil  
40 lbs Water*

Oil.....

Total Depth *3244*

**PRODUCTION**

*9/20/31. Swab 196 lbs Oil  
20 lbs Water*

1st 24 hrs. Nat.....

1st 24 hrs. after shot.....

*9/21/31 Swab 178 lbs Oil  
20 lbs Water*

Gas..... Cu. Ft.

Dry Hole.....

Abandoned.....

*may Deepen.*

Date

SEP 23 1931

**CHAS. L. SHERWOOD**

*Handwritten scribbles and lines, possibly representing a signature or a large mark.*

Returned	<i>JK</i>
Cards	<i>JK</i>
Tracing	<i>OK</i>
France Map	<i>X</i>
Scarborough Map	<i>X</i>
Moody Map	<i>X</i>
Scarborough Port	<i>X</i>
Moody Flat Book	

49

Rice

Map No. **KANSAS** Sec. **21** Twp. **19** R. **9** <sup>W</sup>

Well No. **1** *Beyers*  
*Much Bros* Company

Contractor

COMPLETED

330 Ft. from N. Line

..... Ft. from S. Line

330 Ft. from E. Line

..... Ft. from W. Line

*Ch well map for completion.  
Completed on tracing.*

SECTION PLAT

	0		

Location.....

Rig up.....

Drilling and Remarks:

*Swab 168 Bls  
10% water*

RECORD

Cased 3 in., ..... ft.

Sand 3273-44

Gas.....

Oil.....

Total Depth 3244

PRODUCTION

1st 24 hrs. Nat.....

1st 24 hrs. after shot.....

Gas..... Cu. Ft.

Dry Hole.....

Abandoned.....

Date

SEP 30 1931

192 CHAS. L. SHERWOOD  
Scout

*Done*  
*no*  
*Free*  
*PP*

Returned	<i>TP</i>
Cards	<i>TP</i>
Tracing	<i>MUS</i>
France Map	<i>X</i>
Scarborough Map	<i>X</i>
Moody Map	<i>X</i>
Scarborough Plat Book	
Moody Plat Book	