


Rice

Form 51-5M-11-31-Palace

Map No. **KANSAS** Sec. 21 Twp. 19 R. 9W

Well No. 1 Beyer Farm
Magnolia Company

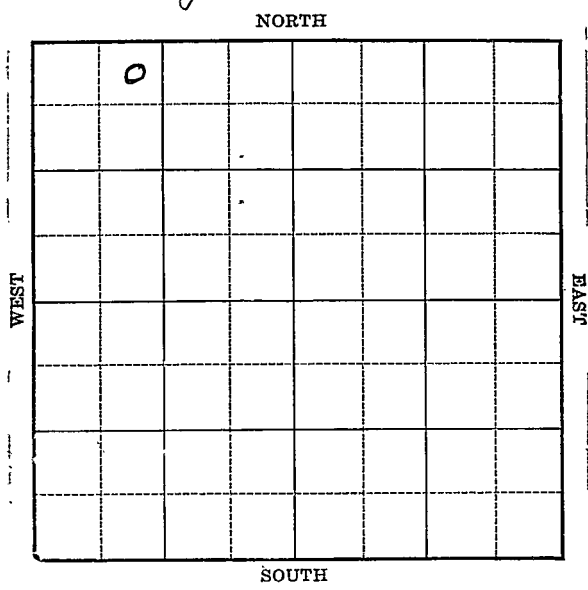

Location _____
Drilling Remarks _____

Rig Up _____
Drilling Remarks _____

RECORD

Cased _____ in. _____ ft.
Sand _____
Gas _____
Oil _____
Total Depth _____

PRODUCTION

1st 24 hrs. Nat. _____
1st 24 hrs. after shot _____
Gas _____ cu. ft.
Dry Hole _____
Abandoned _____

Rice

Map No. **KANSAS** Sec. 21 Twp 19 R. 9W

Well No. 1 Beyer Farm


Magnolia Company

330 Ft. from N. Line

_____ Ft. from S. Line

_____ Ft. from E. Line

990 Ft. from W. Line

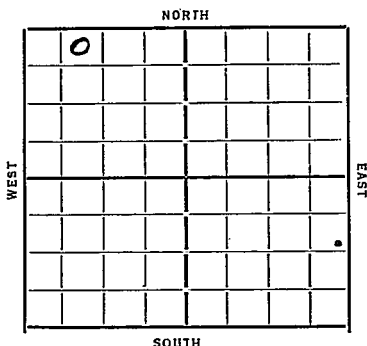

Date 1934

REPORT

5/2 Location
5/10 Rig
5/18 Rign
5/25 13" 246
5/31 ddy 1935
6/7 ddy 3020
6/14 570 3168
6/21 B. K. C. 3166 9" 3168 Rust
6/28 —
7/5 Cong. 3231-70 J.O. C.O.
7/11 Siliceous 3240 TD 3292
HFV D & A

ABANDONED

KANSASMap No. 49 Sec. 21 Twp. 19 R. 9hWell No. 1- BeyerMagnolia Company

Contractor

SECTION PLAT

FIRST REPORTS

330 Ft. from N. Line

_____ Ft. from S. Line

_____ Ft. from E. Line

990 Ft. from W. Line

0			

Location ✓

Rig up _____

Drilling and Remarks:

RECORD

Cased _____ in., _____ ft.

Sand _____

Gas _____

Oil _____

Total Depth _____

PRODUCTION

1st 24 hrs. Nat. _____

1st 24 hrs. after shot _____

Gas _____ Cu. Ft.

Dry Hole _____

Abandoned _____

Date

5-2-37

19

JAMES SCHRECK

Scout

Map No. 49 Sec. 21 Twp. 19 R. 9W

Well No. 1-Beyes

Magnolia Company

Contractor

ABANDONED

SECTION PLAT

0			

330 Ft. from N. Line

_____ Ft. from S. Line

_____ Ft. from E. Line

790 Ft. from W. Line

Location _____

Rig up _____

Drilling and Remarks:

H. F. W.
10 + 77

RECORD

Cased _____ in., _____ ft.

Sand silicious 3240

Gas _____

Oil _____

Total Depth 3292

PRODUCTION

1st 24 hrs. Nat. _____

1st 24 hrs. after shot _____

Gas _____ Cu. Ft.

Dry Hole _____

Abandoned _____

Date

7-11-34 19

ORVAL MANNSCHRECK

Scout