


Map No. KANSAS Sec. 21 Twp. 19 R. 9WWell No. 3-Byer FarmSmith-Ash & Phillips Company

NORTH

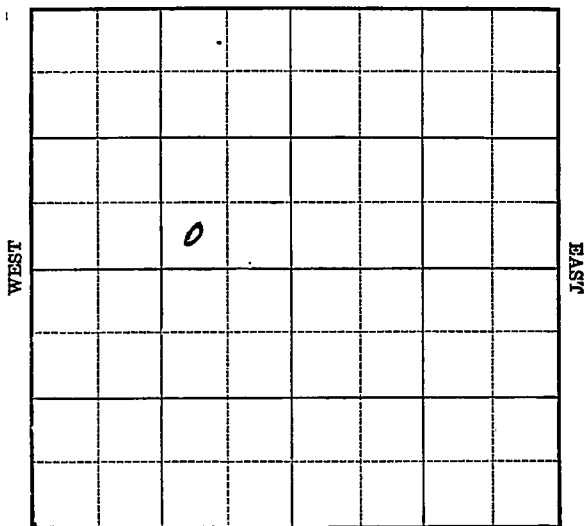

SOUTH

Location _____

Drilling Remarks _____

RECORD

Cased _____ in. _____ ft.

Sand _____

Gas _____

Oil _____

Total Depth _____

Rig Up _____

Drilling Remarks _____

PRODUCTION

1st 24 hrs. Nat. _____

1st 24 hrs. after shot _____

Gas _____ cu. ft.

Dry Hole _____

Abandoned _____

Rice

Map No. KANSAS Sec. 21 Twp. 19 R. 9W

Well No. 3 Byer Farm
Smith-Ash & Phillips Company

NORTH

 Ft. from N. Line

330 Ft. from S. Line

990 Ft. from E. Line

 Ft. from W. Line

WEST

EAST

SOUTH

Date

REPORT

1935
3/30 Location
3/28
4/4 Bldg Rig
4/11 Rig
4/18 Rgm
4/26 ddy 1020 15" 187
5/2 " 1745
5/9 " 2125 10" 1746.
5/16 T 2690 Run 8"
5/23 K C 2913 6" 3103 T 3145
Rep Engine
5/29 Hil 3273 S.O. 3282-84
5" liner 3284 T 3295
6/6 1100 '96 hrs Reacsize
6/13 P 60 5112 W 24 hrs.
6/20 35 Oil & 20 W.
6/26 Hil 3273
T 3295
Oil ~~3273~~ 3284-95
35 Bbls oil
2 " water

COMPLETED

Map No. 49 Sec. 21 Twp. 19 R. 9WWell No. 3-ByerSmith-Ash & Phillips Company

Contractor


FIRST REPORTS

SECTION PLAT

Ft. from N. Line

330 Ft. from S. Line990 Ft. from E. Line

Ft. from W. Line

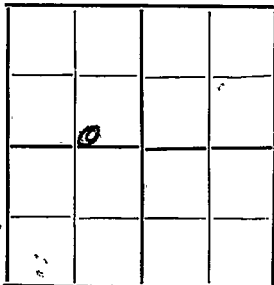Location ☒

Rig up

Drilling and Remarks:

RECORD

Cased.....in., ...ft.

Sand.....

Gas.....

Oil.....

Total Depth.....

PRODUCTION

1st 24 hrs. Nat.....

1st 24 hrs. after shot.....

Gas.....Cu. Ft.

Dry Hole.....

Abandoned.....

Date

ORVAL MANNSCHRECK

3-20-25 192.....

Scout

Map No. 49 Sec. 21 Twp. 19 R. 9NWell No. 3 ByersSmith, Ash & Phillips company


Contractor

SECTION PLAT

Ft. from N. Line

230 Ft. from S. Line990 Ft. from E. Line

Ft. from W. Line

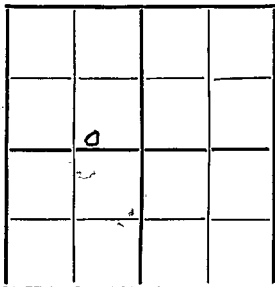

COMPLETED

Location.....

Rig up.....

Drilling and Remarks:

Sil 3273.
Dil 3284-9535 ft vent
2 " water

RECORD

Cased.....in., ...ft.

Sand.....

Gas.....

Oil.....

Total Depth 3285

PRODUCTION

1st 24 hrs. Nat.....

1st 24 hrs. after shot.....

Gas.....Cu. Ft.

Dry Hole.....

Abandoned.....

Date

6/26/35 192.....

ORVAL MANNSCHRECK

Scout