


Section 21 Township 19 Range 2W

Well No. #1 I.B. Decker

Company National Assoc. Pet.

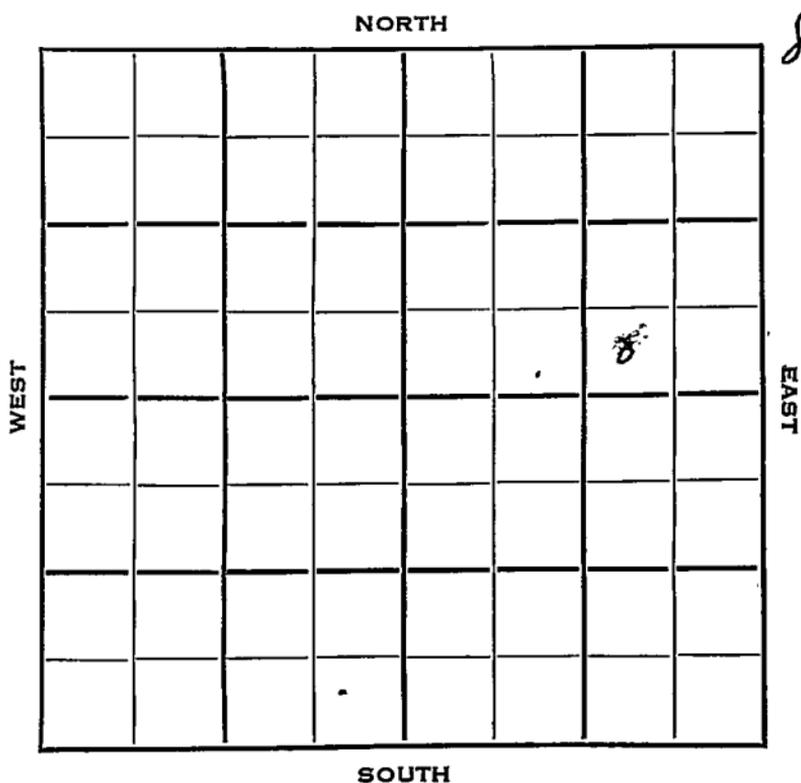

McPherson

KANSAS

SEC.	TWP.	R.
21	19	2 W

WELL NO.

#. 1 I. B. Decker

FARM

COMPANY

National Assoc. Pet.

CONTRACTOR

Lincoln Drlg.

Lively Pool


\_\_\_\_\_ Ft. from N. Line

330 \_\_\_\_\_ Ft. from S. Line

990 \_\_\_\_\_ Ft. from E. Line

\_\_\_\_\_ Ft. from W. Line

SW SE NE

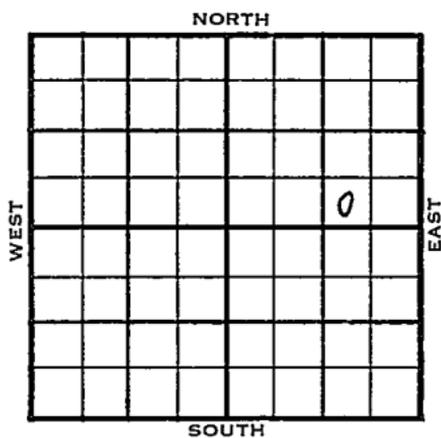

ELEVATION

REPORT

1954

1516'

4/7

Spud 4-1-54  
8" @ 154 Lans. 2332  
Drlg. 2475'

6/9

Spud 4-1-54 Oil well TD 2978  
8" @ 154 Lans 2332 Miss 2960  
TD 2965 5" @ 2962 DD 2978  
B/80 GO 24 GWPH 6 hr. 36/2956-62  
S/1/2 BO 1 BWPH PB 2963 1/2 BOPH  
500 A S/1/2 BOPH st-frac. S/5 BO  
2 BWPH 12 hr. Comp. 45 BOPD 55 BW

**COMPLETED**



