


Section 21 Township 19 Range 2 W

Well No. #<sup>3</sup>/<sub>2</sub> Galva Unit #2

Company Musgrove Pet.

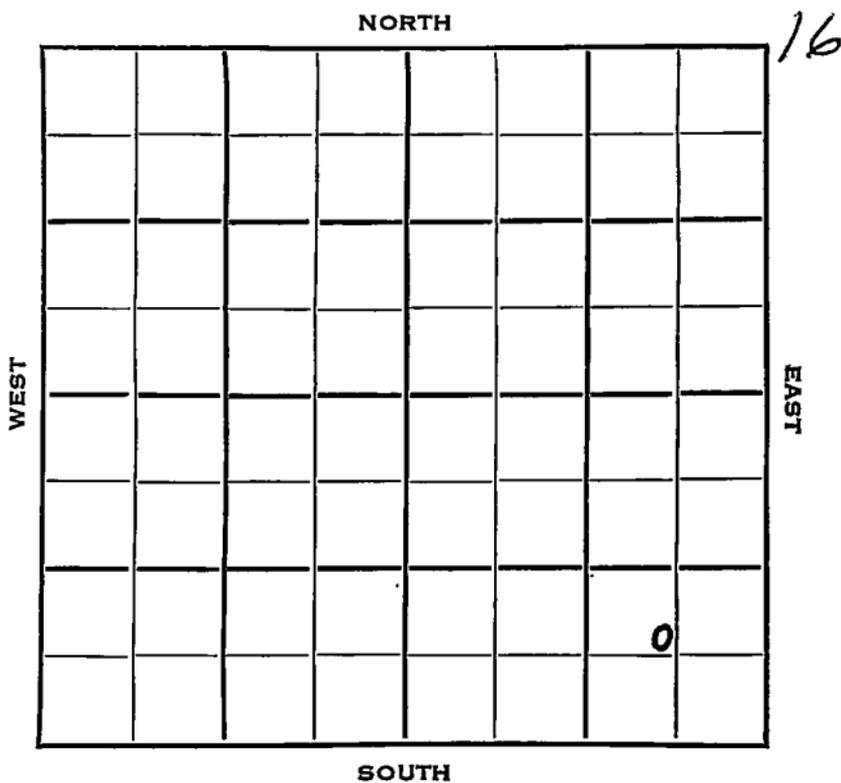

SEC.	TWP.	R.
21	19	2W

WELL NO. 3  
~~2~~ Galva Unit #2 FARM

COMPANY  
 Musgrove Petr.

CONTRACTOR  
 Musgrove  
 Lively Pool


\_\_\_\_\_ Ft. from N. Line

731 \_\_\_\_\_ Ft. from S. Line

703 \_\_\_\_\_ Ft. from E. Line

\_\_\_\_\_ Ft. from W. Line

NW SE SE

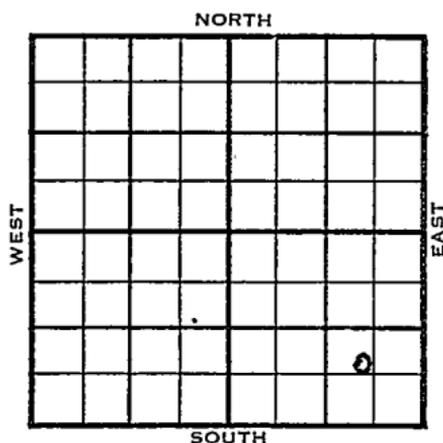

	ELEVATION	REPORT
1953	Elev. 1542'	

9/9 Spud 9-1-53  
 8" @ 174'  
 Anhy 745'  
 Drlg. 2475'

9/16 Miss 2947  
 RTD 2957  
 4" @ 2950'

9/23 DD 2954½' TD 500' oil 2 hrs.  
 1000 A Sd-0-frac.

9/30 S/ 15 boph 20 hrs.

10/7 NR

10/21 Spud 9-1-53 Oil well TD 2954'  
 8" @ 174' Anhy 745' Miss 2947  
 TD 2951 4" @ 2950 DD 2954  
 FU 500' oil 2 hr. 1000 A  
 sd-oil-frac. S/15 BOPH 20 hr.  
 Comp. 245 BOPD

**COMPLETED**



Map No. \_\_\_\_\_ Sec. 21 Twp. 19 R. 2WWell No. 3 Galva Unit #2

Musgrove Pet. \_\_\_\_\_ Company \_\_\_\_\_

**CORRECTION** Contractor \_\_\_\_\_

NW SE SE

## SECTION PLAT

\_\_\_\_\_ Ft. from N. Line

731 Ft. from S. Line703 Ft. from E. Line

\_\_\_\_\_ Ft. from W. Line

			o

McPherson County

Location \_\_\_\_\_

Rig up \_\_\_\_\_

Drilling and Remarks:

Reported

#2

## RECORD

Cased \_\_\_\_\_ in., \_\_\_\_\_ ft.

Sand \_\_\_\_\_

Gas \_\_\_\_\_

Oil \_\_\_\_\_

Total Depth \_\_\_\_\_

## PRODUCTION

1st 24 hrs. Nat. \_\_\_\_\_

1st 24 hrs. after shot \_\_\_\_\_

Gas \_\_\_\_\_ Cu. Ft.

Dry Hole \_\_\_\_\_

Abandoned \_\_\_\_\_

Date

SEP 16 1959

J. G. McGEHEE

Scout

