
McPherson KANSAS

DX 78-1

Section 21 Township 19 Range 2W

Well No. 13 Galva Unit

Company Musgrove Pet.

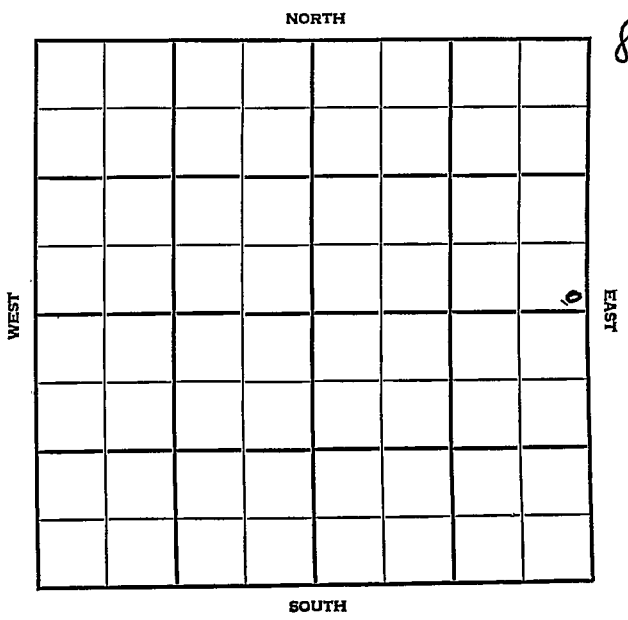

McPherson KANSAS

SEC.	TWP.	R.
21	19	2W

WELL NO. 13 Galva Unit FARM

COMPANY

CONTRACTOR Musgrove Pet.

Musgrove

Lively Pool


_____ Ft. from N. Line

275 Ft. from S. Line

108 Ft. from E. Line

_____ Ft. from W. Line

SE SE NE

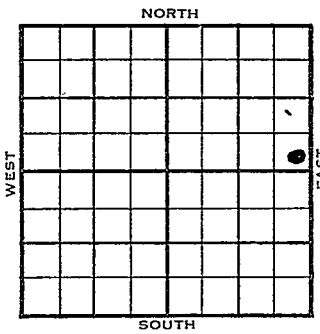

	ELEVATION	
1954	1546'	REPORT

6/9 Spudding 6-4-54
8" @ 174
Drlg. 1833

7/14 Spud 6-4-54 - Oil Well
TD 2949'
8" @ 174'
Miss 2942'
TD 2945'
5" @ 2944'
DD 2949'
S/14 goph 16 hrs.
Hydro.
Comp. 182 bopd

COMPLETED

DX-78

FORM 275 FOR SALE BY KANSAS BLUE PRINT CO.

County McPherson State Kansas

Sec. 21 (Blk. Twp.) 19 (Sur. Rge.) 2W Map No.

Operator Musgrove Pet.

Well No. 13 Farm Galva Unit

Elev. Location SE SE NE



275 Ft. From S Line NE

108 Ft. From E Line Quarter

1st. Report JUN 9 1954

Completion

Remarks Musgrove - Contr.

Spudding Date 6-4-54

Drlg. Data Lively Pool

8" @ 174 drlg. 1833

J. G. McGEHEE

FORM 275 FOR SALE BY KANSAS BLUE PRINT CO.


County McPherson State Kansas

Sec. 21 (Blk. Twp.) 19 (Sur. Rge.) 2W Map No.

Operator Musgrove Pet.

Well No. 13 Farm Galva Unit

Elev. 1546 Location SE SE NE

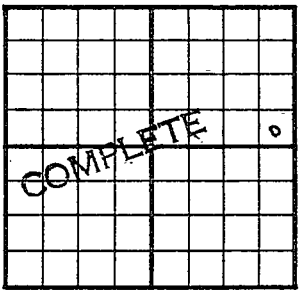

275 Ft. From S Line NE

108 Ft. From E Line Quarter

1st. Report

Completion JUL 14 1954

Remarks Lively Pool
Musgrove - Contr.

Spudding Date 6-4-54

Drlg. Data Oil well TD 2949

8" @ 174 Miss. 2942 TD 2945 5" @ 2944

DD 2949 S/ 14 goph 16 hr. Hydro.

Comp. 182 bopd

J. G. McGEHEE