


Section 21 Township 19 Range 2W

Well No. 12 Galva Unit

Company Musgrove Petr.

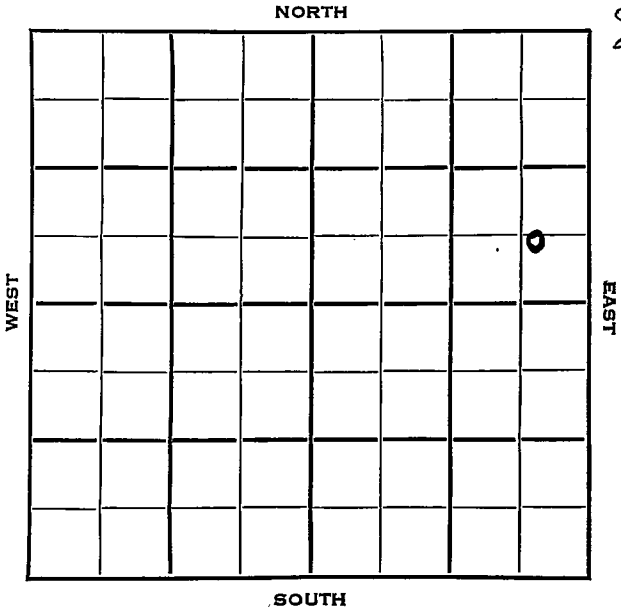

SEC.	TWP.	R.
21	19	2W ✓

WELL NO.

12 Galva Unit

FARM

COMPANY

Musgrove Petr.

CONTRACTOR

Lively Pool

Ft. from N. Line

620


Ft. from S. Line

573

Ft. from E. Line

Ft. from W. Line

SE SE NE

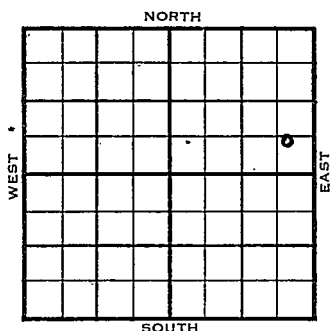

	ELEVATION	REPORT
1954	1547'	
1/20	Spud 1-17-54 8" @ 167' Drlg. 853'	
1/27	Miss 2943' RTD 2946' 4" @ 2944'	
2/3	CO 2946', SO DD 2951', Miss 2950' B/1 goph 7 hrs. S/ 3/4 BO DD 2953 1/2 frac.	
2/10	S/6 1/2 BOPH 4 hrs. Dec. to 5 BOPH 5th hr	
2/17	NR	
3/3	NR	
3/10	"	
3/17	Spud 1-17-54 Oil Well TD 2953' 8" @ 167' Ero Miss 2943'	

OVER

1954

Information brought forward.

3/17

TD 2946'

4" @ 2944'

CO to 2946'

DD 2951'

Miss 2950'

B/ 1 goph 7 hr. S/ 3/4 bo

DD 2953'

frac. S/ $6\frac{1}{2}$ boph 4 hr.

dec. to 5 boph

Comp 81 bopd. 11% Wtr.


COMPLETED

JAN 21 1954

Small Maps	60
Land Small Map	3
Land Wall Map	
Tracings	
Fence Map	
Pierce Map	
Misc.	

Orig. Date

County McPherson State Kansas
 Sec. 21 (Blk. 19) (Sur. 2W) (Rge.) Map No.
 Operator Musgrove Pet.
 Well No. 12 Farm Galva Unit
 Elev. 1547 Location SE SE NE

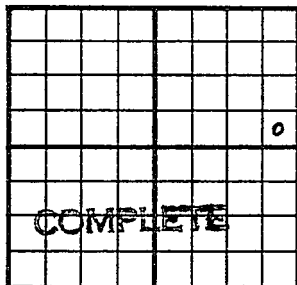

620 Ft. From S Line NE
573 Ft. From E Line Quarter

Ist. Report

Completion MAR 17 1954

Remarks Lively Pool

Spudding Date 1-17-54

Drlg. Data Oil well TD 2953
8" @ 167 EroMiss. 2943 TD 2946
4" @ 2944 CO to 2946. DD 2951
Miss. 2950 B/ 1 goph 7 hr. S/ 3/4 bo
DD 2953 frac S/ 6 1/2 boph 4 hr.
dec. to 5 boph Comp. 81 bopd 11% wtr.

J. G. McGEHEE

Scout Cards	
Land Small Map	
Land Wall Map	
Tracings	
France Map	
Pierce Map	
Misc.	

MAR 23 1954

Orig. Data