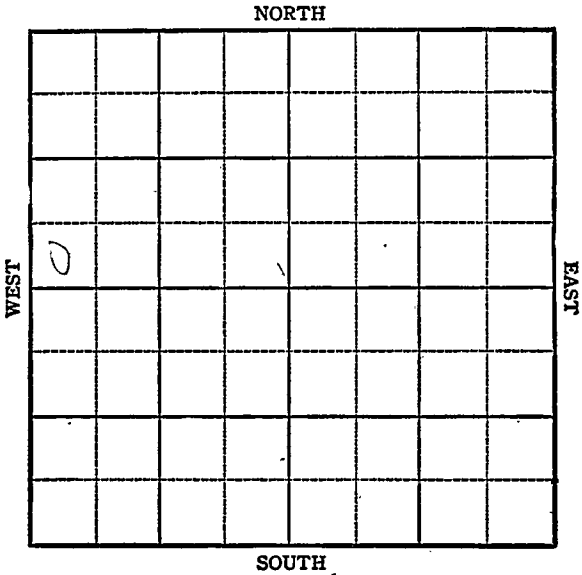


FORM 51 5M BR1X

KANSAS

Section 21 Township 19 Range 2WWell No. #1 RobertsonCompany J. C. Jensen et al

KANSAS

McPherson

Sec. 21 Twp. 19 R. 2W

Well No. #1 Robertson Farm

J. C. Jensen etal Company


Wildcat

 Ft. from N. Line

330 Ft. from S. Line

 Ft. from E. Line

330 Ft. from W. Line

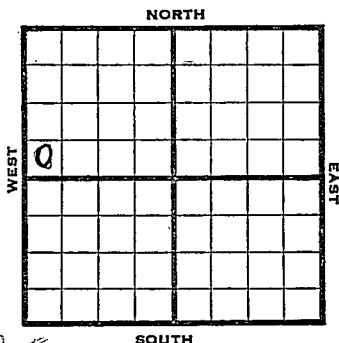

SW NW 8000.1542

1944

R E P O R T

12/6 8" @ 122' WOC

12/14 Lans 2351
Drlg. 2400'


12/20 Miss 2981
TD 3004'

ABANDONED

Pool Name WildcatMap No. 43 Sec. 21 Twp. 19 R. 2WWell No. 1 RobertsonJ. C. Jensen et al CompanyFIRST REPORT Contractor

SW NW

SECTION PLAT

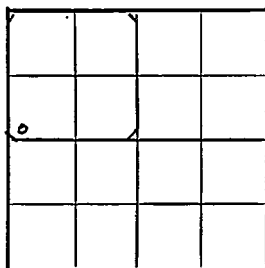 Ft. from N. Line330 Ft. from S. Line Ft. from E. Line330 Ft. from W. LineMcPhersonLocation Rig up

Drilling and Remarks:

8"-122 WOC

RECORD

Cased in., ft.Sand Gas Oil Total Depth

PRODUCTION

1st 24 hrs. Nat. 1st 24 hrs. after shot Gas Cu. Ft.Dry Hole Abandoned

Date

DEC 6 194419S. J. LEWIS

Scout

Pool Name WildcatMap No. 43 Sec. 21 Twp. 19 R. 2WWell No. 1 RobertsonJ.C. Jensen et al CompanyABANDONED Contractor

SW NW

SECTION PLAT

 Ft. from N. Line330 Ft. from S. Line Ft. from E. Line330 Ft. from W. LineMcPhersonLocation Rig up

Drilling and Remarks:

Miss 2981

RECORD

Cased in., ft.Sand Gas Oil Total Depth 3004

PRODUCTION

1st 24 hrs. Nat. 1st 24 hrs. after shot Gas Cu. Ft.Dry Hole Abandoned

Date

DEC 20 1944

19

S. J. LEWIS Scout