

McPherson

KANSAS

SEC.	TWP.	R.
21	19	2W

WELL NO.

#1 Russell

FARM

COMPANY

Bennett & Gould.

CONTRACTOR

Salina Drlg.

Lively Pool

990


Ft. from N. Line

Ft. from S. Line

330

Ft. from E. Line

Ft. from W. Line

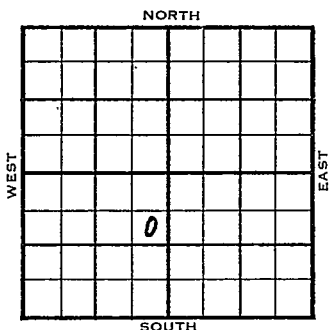

SE NE SW

1954	ELEVATION 1540'	REPORT
------	--------------------	--------

12/29

Spud 12-24-54
8" @ 153'
Drlg. 1050'


1955

1/19

Spud 12-24-54
D & A
TD 2984'
8" @ 153'
Lans 2339' Miss 2970'
DST 2971'-74' opn 1 hr, rec 15' socm
100#
TD 2974'
5" @ 2971'
DD 2982'
FU 320' wtr. 8 hr. DD2984' wtr.
D & A

ABANDONED

County McPherson State Kansas
 Sec. 21 (Blk.) 19 (Sur.) 2W Map No.
 Operator Bennett & Gould
 Well No. 1 Farm Russell
 Elev. _____ Location SE NE SW

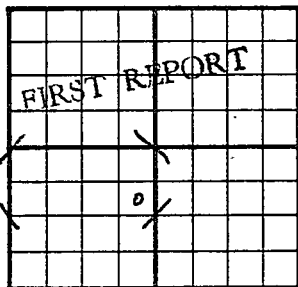


990 Ft. From N Line SW
330 Ft. From E Line Quarter
 1st. Report DEC 29 1954
 Completion _____
 Remarks _____
Salina Drlg. - Contr.
 Spudding Date 12-24-54

Drlg. Data Lively Pool
8" @ 153 drlg. 1050

FABEN GILSTRAP

County McPherson State Kansas
 Sec. 21 (Blk. 19 (Sur. 2W Map No. 19)
 Operator Bennett & Gould
 Well No. 1 Farm Russell
 Elev. 1540 Location SE NE SW

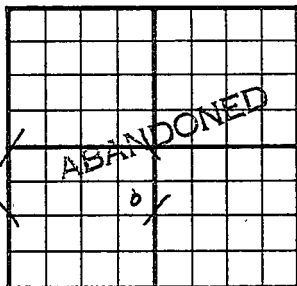

990Ft. From N Line SW
 330Ft. From E Line Quarter
 Ist. Report
 Completion JAN 1 9 1955
 Remarks Lively Pool
Salina Drlg. - Contr.
 Spudding Date 12-24-54

Drlg. Data D & A TD 2984
8" @ 153 Lans. 2339 Miss. 2970
DST 2971-74 open 1 hr. Rec. 15' socm
100# TD 2974 5" @ 2971 DD 2982
FU 320' wtr. 8 hr. DD 2984 wtr.

D & A

FABEN GILSTRAP