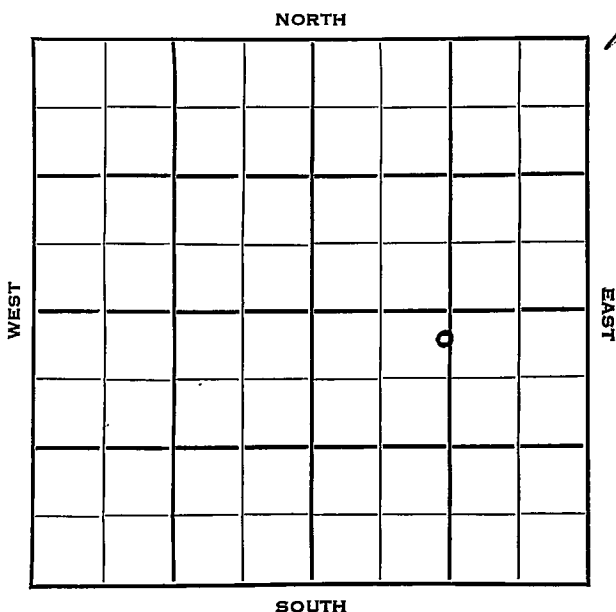


Section 21 Township 19 Range 2WWell No. 13 Unruh "B"Company National Assoc. Petr.

McPherson

KANSAS

SEC.	21	TWP.	19	R.	2W	✓
------	----	------	----	----	----	---

WELL NO. ~~#1 UNRUH "B"~~
~~#3 UNRUH~~

FARM

COMPANY

National Assoc. Pet.

CONTRACTOR

Lincoln


Lively Pool

230 Ft. from N. Line

Ft. from S. Line

Ft. from E. Line

1227 Ft. from W. Line

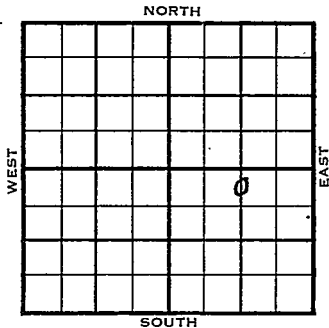C N $\frac{1}{2}$ N $\frac{1}{2}$ SE

ELEVATION

REPORT

1954 1544'

2/24 Spud 2-16-54
 8" @ 160'
 KC 2329'
 Drlg 2861'

3/3 Miss 2960'
 RTD 2966'
 5" @ 2962'
 CO 2966'
 S/6 boph + trac e 8 hrs.

3/10 NR

3/17 "

3/24 Spud 2-16-54 Oil well TD 2966
 8" @ 160 KC 2329 Miss 2960
 TD 2966 5" @ 2962 CO to 2966
 S/6 BOPH 8 hr.
 Comp. 80 BOPD 3% wtr.

COMPLETED

County **McPherson** State **Kansas**Sec. **21** (Blk. Twp.) **19** (Sur. Rge.) **2W** Map No.Operator **National Assoc. Pet.**Well No. **3** Farm **Unruh**Elev. Location **C N $\frac{1}{2}$ N $\frac{1}{2}$ SE**

230 Ft. From **N** Line **SE****1227** Ft. From **W** Line **Quarter**1st. Report **FEB 24 1954**


Completion

Remarks

Lincoln - Contr.Spudding Date **2-16-54**Drlg. Data **Lively Pool****8" @ 160 KC 2329 drlg. 2861**

Map No. _____ Sec. 21 Twp. 19 R. 2WWell No. 1 Unruh "B"_____
National Assoc. Pet. _____ Company**CORRECTION**_____
C $N\frac{1}{2}$ $N\frac{1}{2}$ SE Contractor

SECTION PLAT

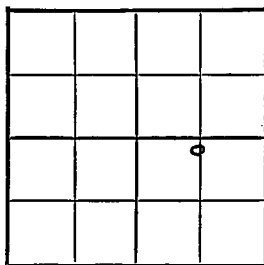230 Ft. from N. Line_____
Ft. from S. Line_____
Ft. from E. Line1227 Ft. from W. LineMcPherson County

Location _____

Rig up _____

Drilling and Remarks:

Reported

#3 Unruh

RECORD

Cased _____ in., _____ ft.

Sand _____

Gas _____

Oil _____

Total Depth _____

PRODUCTION

1st 24 hrs. Nat. _____

1st 24 hrs. after shot _____

Gas _____ Cu. Ft.


Dry Hole _____

Abandoned _____

Date

MAR 24 1954₁₉J. G. McGEHEE Scout

County McPherson State Kansas
 Sec. 21 (Blk.) 19 (Sur.) 2W Map No. _____
 Operator National Assoc. Pet.
 Well No. 1 Farm Unruh "B"
 Elev. 1544 Location C N $\frac{1}{2}$ N $\frac{1}{2}$ SE

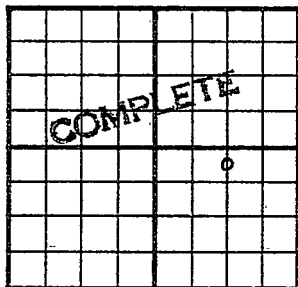

230 Ft. From N Line SE
1227 Ft. From W Line Quarter
 Ist. Report _____
 Completion MAR 24 1954
 Remarks Lively Pool
Lincoln - Contr.
 Spudding Date 2-16-54

Drilg. Data Oil well TD 2966
8" @ 160 KC 2329 Miss. 2960
TD 2966 5" @ 2962 CO to 2966
S/ 6 boph 8 hr. Comp. 80 bopd 3% wtr.