

DX 78-1 Barton


KANSAS

Section 21 Township 19 Range 13W

Well No. 1 Doonan

Company Kim Oil

24

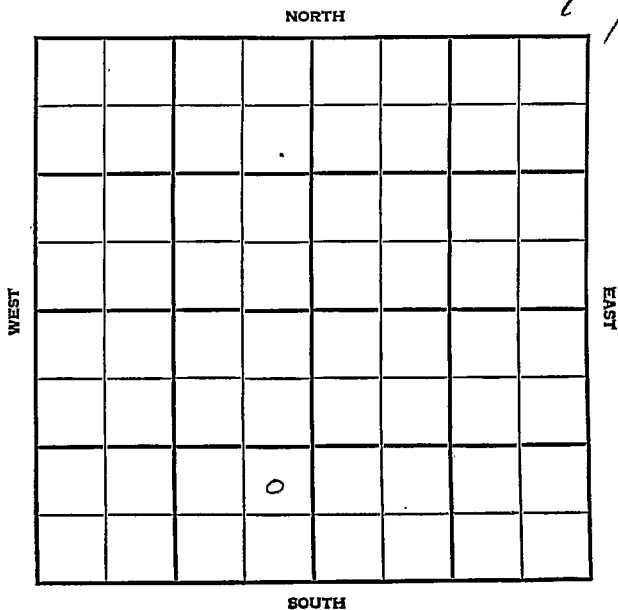

| | | |
|------|------|-----|
| SEC. | TWP. | R. |
| 21 | 19 | 13W |


WELL NO. #1 Doonan FARM

COMPANY Kim Oil

CONTRACTOR Sidey

Et. Bend Townsite Pool

_____ Ft. from N. Line
 1200 _____ Ft. from S. Line
 75 _____ Ft. from E. Line
 _____ Ft. from W. Line

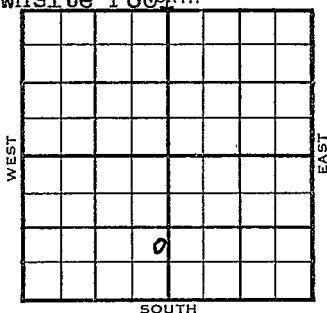

NE SE SW

| | | |
|------|-----------------|--------|
| 1955 | ELEVATION 1852' | REPORT |
|------|-----------------|--------|

4/27 Spud 4-21-55
 8" @ 750'
 Anhy 740'
 Drlg. 1920'

6/15 DST 3309-58, open 1/2 hr. Rec. 210' ho
 & gcm 390# 5 1/2 1/4 3443 DD 3446 FU 635'
 oil 36 hr. 250 A S/4.59 boph 2 hr.
 Comp F&P 38 bopd.

| | | |
|------|------|------|
| Tips | | |
| Anh. | 740 | |
| H. | 3059 | 1207 |
| B.L. | 3159 | 1307 |
| L. | 3171 | 1319 |
| C. | 3393 | 1541 |
| A. | 3442 | 1590 |
| TD. | 3444 | |

COMPLETED

County Barton State Kansas

Sec. 21 (Blk. 19) (Twp. 19) (Sur. Rge.) 13W Map. No.

Operator Kim Oil

Well No. 1 Farm Doonan

Elev. 1852 Location NE SE SW

| | | | | | |
|--------------|--|--|--|--|--|
| | | | | | |
| | | | | | |
| | | | | | |
| | | | | | |
| FIRST REPORT | | | | | |
| | | | | | |
| | | | | | |
| | | | | | |
| | | | | | |

1200 Ft. From S Line SW

75 Ft. From E Line Quarter

Ist. Report APR 27 1955

Completion _____

Remarks _____

Sidey - Contr.

Spudding Date 4-21-55

Drlg. Data Gt. Bend Townsite Pool

8" @ 750 Anhy 740 drlg. 1920

FABEN GILSTRAP

County Barton Elev. 1852
 Sec. 21 Twp. 19 Rge. 13W
 Company Kim Oil
 FarmName Doonan No. 1

| TOPS | DEPTH | LOG | DATUM |
|--------|-------|-----|-------|
| Anh. | 740 | | |
| Tr. | 3059 | | 1207 |
| Dg. | | | |
| Bl. | 3159 | | 1307 |
| L. | 3171 | | 1319 |
| K.C. | | | |
| B.K.C. | | | |
| Ce. | | | |
| C. | 3393 | | 1541 |
| M. | | | |
| M. | | | |
| K. | | | |
| Mz. | | | |
| Ma. | | | |
| V. | | | |
| S. | | | |
| S. | | | |
| A | 3442 | | 1590 |
| R. | | | |
| PE. | | | |
| G. | | | |
| T.D. | 3444 | | |

Loc. in Sec. _____
 NE SE SW
 1200' SL
 75' EL
 Geol. _____
 Contr. _____
 Pool _____
 Gt. Bend Twst. _____

| | | |
|---------------|--|--|
| COMPLETE 0 | | |
|---------------|--|--|

Date Comm. 4-21-55 JUN 15 1955

8" @ 750/200 DST 3309-58 open $\frac{1}{2}$ hr.
 Rec. 210' ho & gcm 390# $5\frac{1}{2}$ " $\frac{1}{4}$ 3443
 DD 3446 FU 635' oil 36 hr. 250 A
 S/ 4.59 boph 2 hr.
 Comp. F & P/ 38 bopd

Co. Lse. No. Sec. T. R.