

Barton


FORM 51

KANSAS

Section 21 Township 19 Range 13^W

Well No. #1 Carothers

Company Honaker Drilg.

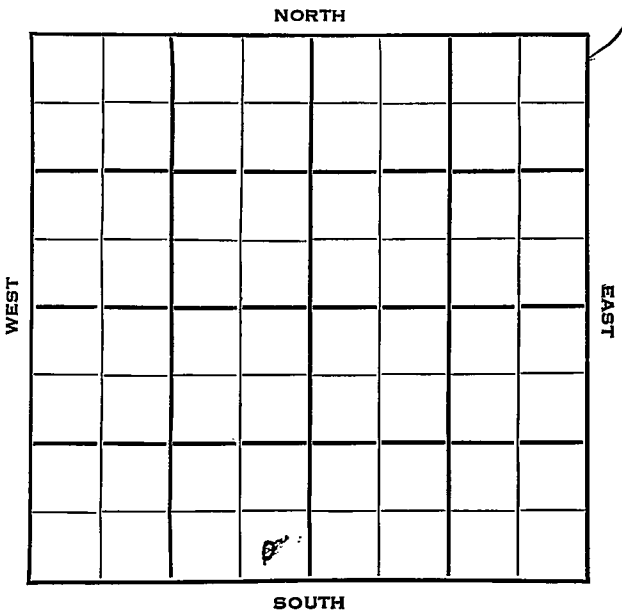

Barton KANSAS

SEC. 21 TWP. 19 R. 13W ✓

WELL NO. 1 Carothers FARM

COMPANY Honaker Drlg.

CONTRACTOR Stickle Drlg.

Gt. Bend Townsite Pool

_____ Ft. from N. Line

330 _____ Ft. from S. Line

330 _____ Ft. from E. Line

_____ Ft. from W. Line

SE SE SW

	ELEVATION	REPORT
1954	1849'	
3/3		Spud 3-1-54
3/10		8" @ 741' w/400 sks Anhy 731' Drlg. 2758'
4/28		Spud 3-1-54 Oil Well TD 3500' 8" @ 741' Anhy 731', Heeb 3051', Br. Lime 3151' Lans 3164' DST 3180'-3215' opn 1/4 hr, rec 240' gas 35' o & gcm 270# DST 3228'-36' opn 1/4 hr, rec 300' gas 60' vhocm 550# DST 3283'-97' opn 1/3 hr, rec 445' gas 35' gcm 1075# Cong 3391', Arb 3436 DST 3438'-47' opn 1/2 hr, rec 20' Mud 0# DST 3457'-73' opn 1/2 hr, rec 1560' wtr 1100# TD 3500' 5" @ 3406' CO to 3370 22/ 3363-65 500 A 15/ 3359-61 6/ 3365-67 600 A 6/ 3295-

1954

Information brought forward.

4/28

3/ 3286-87 SP 3315

500 A HFO

Comp 170 bopd.

COMPLETED

County **Barton** State **Kansas**

Sec. **21** (Blk. Twp.) **19** (Sur. Rge.) **13W** Map No.

Operator **Honaker Drlg.**

Well No. **1** Farm **Carothers**

Elev. Location **SE SE SW**

330 Ft. From **S** Line **SW**

330 Ft. From **E** Line **Quarter**

1st. Report **MAR 3 1954**

Completion

Remarks

Stickle Drlg. - Contr.

Spudding Date **3-1-54**

Drlg. Data **Gt. Bend Townsite Pool**

