


Section 21 Township 19 Range 13 W

Well No. # 1 Gt. Bend Brick & Harms

Company Harms Pet.

*10*

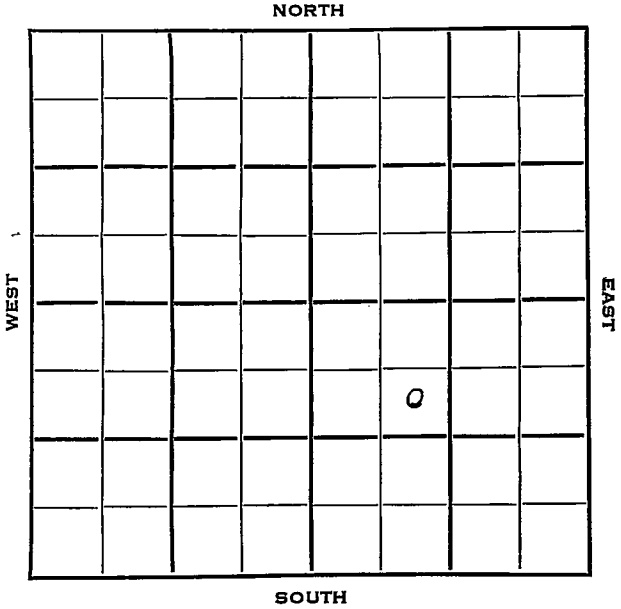

Barton KANSAS


SEC.	TWP.	R.
21	19	13W

WELL NO. 1 Gt. Bend Brick & Harms FARM

COMPANY Harms Petr.

CONTRACTOR Clark Knight

825 \_\_\_\_\_ Ft. from N. Line  
 \_\_\_\_\_ Ft. from S. Line  
 \_\_\_\_\_ Ft. from E. Line  
 990 \_\_\_\_\_ Ft. from W. Line

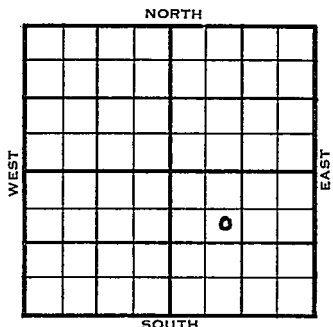

C E L SE NW SE

1953	ELEVATION	REPORT
	1848'	
12/16	Location	
1954 2/3	Spud 12-15-53 D&A TE 3500' 8" @ 755' Anhy 745', Top 2832', Heeb 3070', Tor. 3087', Doug 3102', Br lime 3171', Lans 3182', Cong 3405' DST 3404-20', opn 20 mins., rec. 5' mud, 150# DST 3403-36', opn 1 hr., rec. 44' mud 255# Arb. 3440' DST 3441-53, opn 1 hr., rec. 53' mud, 120# TD 3500' D&A	
<b>ABANDONED</b>		



County Barton State Kansas

Sec. 21 (Blk. Twp.) 19 (Sur. Rge.) 13W Map No.

Operator Harms Pet.

Well No. 1 Farm Gt. Bend Brick & Harms

Elev. 1848 Location C E L SE NW SE

ABANDONED					

825 Ft. From N Line SE

990 Ft. From W Line Quarter

1st. Report

FEB 3 1954

Completion

Remarks

Clark Knight - Contr.

Spudding Date 12-15-53

Drlg. Data D & A TD 3500

8" @ 755 Anhy 745 Top. 2832

Heeb. 3070 Tor. 3087 Doug. 3102

Br. line 3171 Lans. 3182 Cong. 3405

DST 3404-20 open 20 min. Rec. 5' mud

150# DST 3403-36 open 1 hr. Rec. 44'

mud 255# Arb. 3440 DST 3441-53

open 1 hr. Rec. 53' mud 120# TD 3500

D & A