

Barton

KANSAS

SECTION 21 TOWNSHIP 19 RANGE 13 W

WELL NO. #5 Esfeld "A"

COMPANY Westport Properties

NORTH

WEST

EAST

SOUTH

0

15

Barton

KANSAS

SEC. 21	TWP. 19	R. 13W
------------	------------	-----------

WELL NO.

#5 Esfeld "A"

FARM

COMPANY

Westport Properties

CONTRACTOR

Strata

Gt. Bend Twst.

NORTH


Ft. from N. Line

Ft. from S. Line

Ft. from E. Line

Ft. from W. Line

SW SW SE

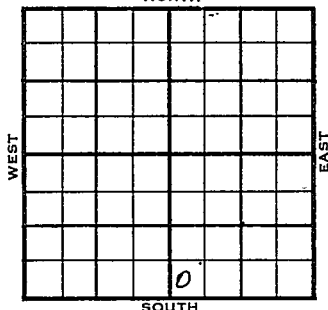

	ELEVATION	REPORT
1955	1848	
11-23	Location	
1956		
2-1	Comm. 12-27-55 8 5/8" @ 745 / 400 5 1/2" @ 3478 CO 30/3292-98, 2000 A S/ 3 goph Comp. F/75 Bopd H. 3051 BL 3149 L. 3161 A. 3426 TD 3480	

COMPLETED

County Barren Elev. _____Sec. 21 Twp. 19 Rge. 13WCompany Westport PropertiesFarm Name Esfeld "A" No. 5

TOPS	DEPTH	LOG	DATUM	Loc. in Sec.
Anh.				SW SW SE
TP.				
H.				
Tr.				
Dg.				
BL.				
L.				Geol.
K.C.				Contr.
B.K.C.				Strata
Ce.				Pool
C.				Gt. Bend Twst.
M.				
M.				
K.				
Mz.				
Ma.				
V.				
S.				
S.				
A.				
R.				
Pe.				
G.				
T.D.				

	NOV 23 '55		
	FIRST REPORT		

Date Comm. _____

Location _____

County Barton Elev. 1848
 Sec. 21 Twp. 19 Rge. 13W
 Company Westport Properties-Pet. Management
 FarmName Esfeld "A" No. 5

TOPS	DEPTH	LOG	DATUM	Loc. in Sec.
Anh.				SW SW SE
Tp.				
H.	3051			
Tr.				
Dg.				
BL.	3149		1301	
L.	3161		1313	Geol.
K.C.				Contr.
B.K.C.				Strata
Ce.				
C.				Pool
M.				Gt. Bend Twst.
M.				
K.				
Mz.				
Mo.				
V.				
S.				
S.				
A.	3426		1578	COMPLETE
R.				
Pe.				
G.				
T.D.	3480			

Date Comm. 12-27-55 FEB 1 1956

8 5/8" @ 745/400 5 1/2" @ 3478

CO to 30/ 3292-98 2000 A

S/ 3 goph Comp. F/ 75 bopd

No Total Depth given
Please advise. Thanks.

Mickey - Scouting

MAR 13 1956

R. G.