
DX 78-1 Barton KANSAS

Section 21 Township 19 Range 14 W

Well No. #1 Essmiller

Company Petroleum Inc.

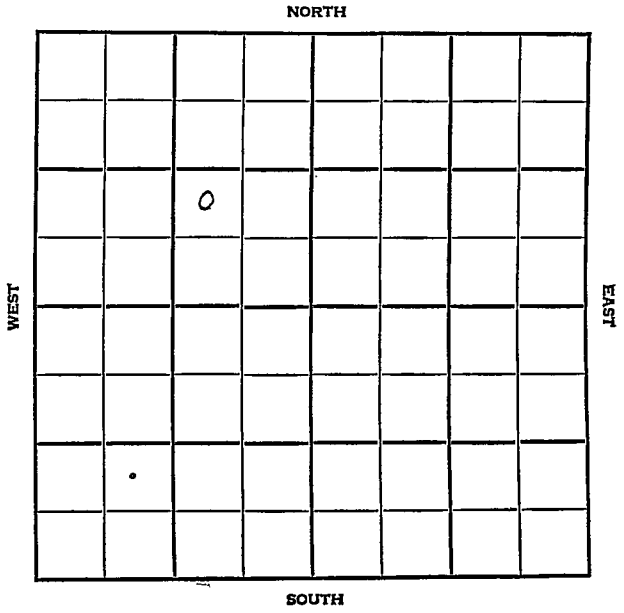

BARTON KANSAS

SEC.	TWP.	R.
21	19	14W

WELL NO.

#1 Essmiller FARM

COMPANY

PETROLEUM INC.

CONTRACTOR

Heizer SW


_____ Ft. from N. Line

_____ Ft. from S. Line

_____ Ft. from E. Line

_____ Ft. from W. Line

NW SE NW

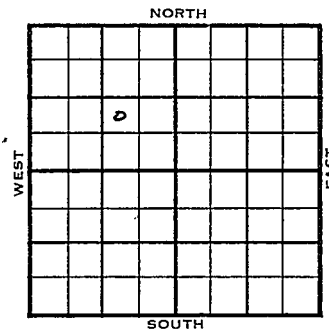

1955	ELEVATION 1886'	REPORT

9/21 Comm 9/16/55
8" @ 801 w/400
D 2370

10/12 Comm 9-16-55
8" @ 801/400

H	3110
Bl	3200
L	3214
Ch Cong	3465
Sd	3485
Sh	3528
TD	3573

DST 3217-60 open 1 hr Rec 33' o & gcm 100/20" DST 3329-80 open 40 min Rec 15' mud 100/20" DST 3478-95 open 1 hr gas in 1 min 2,160 mcfg Rec 30' mud 700/30" DST 3496-3510 open 1 hr gas in 2 min 1,200 mcfg rec 60' o & gcm 750# DST 3519-30 open 1/2 hr Rec 15' mud 0# 5 1/2" @ 3570
CO to 3542 40/3486-3506
Comp shut in gas well 1,700 mcfgpd

COMPLETED

DX-78

FORM 513 REV. SUNRAY

County Barton Elev.

Sec. 21 Twp. 19 Rge. 11W

Company Petroleum Inc.

Farm Name Essmiller No. 1

TOPS	DEPTH	LOG	DATUM
Anh.			
Tp.			
H.			
Tr.			
Dg.			
B.L.			
L.			
K.C.			
B.K.C.			
Ce.			
C.			
M.			
M.			
K.			
Mz.			
Mo.			
V.			
S.			
S.			
A			
R.			
P€.			
G.			
T.D.			

Loc. in Sec. NW SE NW

Geol.

Contr.

Pool Heizer SW

FIRST REPORT

SEP 21 1955

Date Comm. 9/16/55, 8" 801 w/100 D 2370

Co. Lse. No. Sec. T. R.

FORM 513 REV. SUNRAY

County Barton Elev. 1886

Sec. 21 Twp. 19 Rge. 14W

Company Petroleum Inc.

Farm Name Essmiller No. 1


TOPS	DEPTH	LOG	DATUM
Anh.			
T.P.			
H.	3110		1224
Tr.			
Dg.			
Bl.	3200		1314
L.	3214		1328
K.C.			
B.K.C.			
Ge. Ch. Cong	3465		1579
C. sd	3485		1599
M.			
M.			
K.			
Mz.			
Mq.			
V.			
S. sh	3538		1642
S.			
A			
R.			
Pe.			
G.			
T.D.	3573		

Loc. in Sec. NW SE NW

Geol.

Contr.

Pool SW Heizer

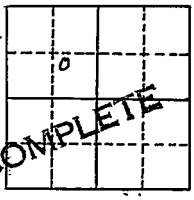

Date Comm. 9-16-55 OCT 12 1955


8" @ 801/400 DST 3217-60 open 1 hr.
Rec. 33' o & gcm 100/20" DST 3329-80
open 40 min. Rec. 15' mud 100/20"
DST 3478-95 open 1 hr. gas in 1 min.
2,160 mcfg rec. 30' mud 700/30"
DST 3496-3510 open 1 hr. gas in 2 min.
1,200 mcfg rec. 60' o & gcm 750#
DST 3519-30 open ½ hr. Rec. 15' mud

OVER

Co. Lse. No. Sec. T. R.

O# 5½" @ 3570 CO to 3542 40/ 3486-3506

Comp. shut in gas well 1,700 mcfgpd

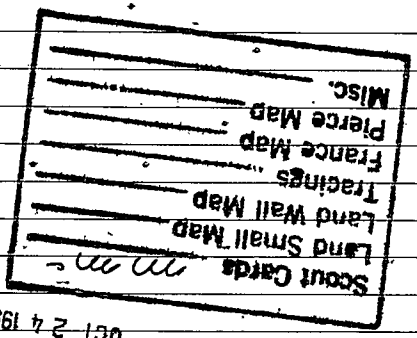

OCT 24 1955