
DX 78-1

Barton KANSAS

Section 21 Township 19 Range 14W

Well No. 1 Miller

Company J. J. Jennings

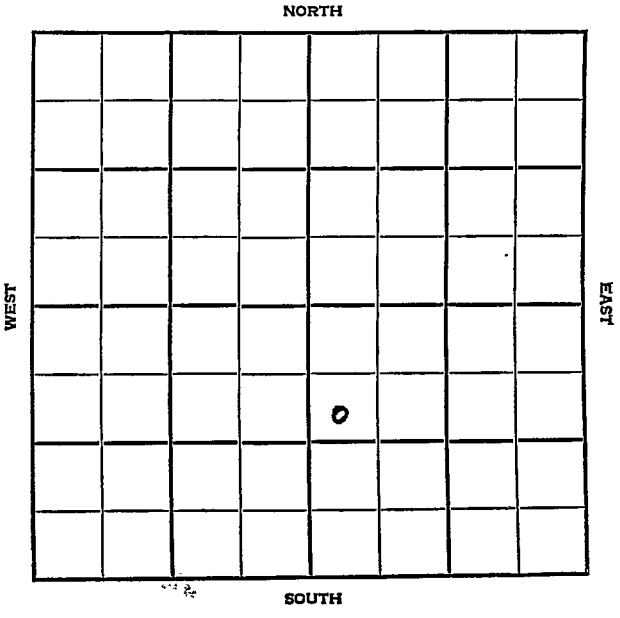

Barton **KANSAS**

SEC.	TWP.	R.
21	19	14W

WELL NO.

#1 Miller FARM

COMPANY

J. J. Jennings.

CONTRACTOR

Badger.


SW Heizer Pool

990 Ft. from N. Line

_____ Ft. from S. Line

_____ Ft. from E. Line

280 Ft. from W. Line

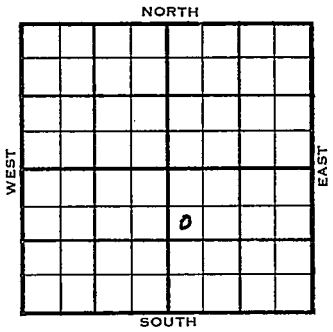

SW NW SE

1955	ELEVATION REPORT
4/20	Spud 3-12-55 8^{ft} @ 822' Drlg. 3157'

DX-78

FORM 275 FOR SALE BY KANSAS BLUE PRINT CO.


County Barton State Kansas

Sec. 21 (Blk. Twp.) 19 (Sur. Rge.) 14W Map No.

Operator J. J. Jennings

Well No. 1 Farm Miller

Elev. Location SW NW SE

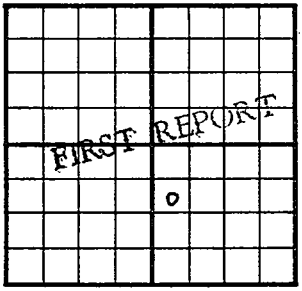

990 Ft. From N Line SE

280 Ft. From W Line Quarter

1st. Report APR 20 1955

Completion

Remarks Badger - Contr.

Spudding Date 3-12-55

Drlg. Data SW Heizer Pool

8" @.822 drlg. 3157

FABEN GILSTRAP