

STATE CORPORATION COMMISSION OF KANSAS
OIL & GAS CONSERVATION DIVISION
WELL COMPLETION OR RECOMPLETION FORM
ACO-1 WELL HISTORY
DESCRIPTION OF WELL AND LEASE

Operator: License # 8996
Name Mid-Continent Resources
Address P. O. Box 399
City/State/Zip Garden City, Kansas 67846

Purchaser Clear Creek

Operator Contact Person Cecil Q'Brate
Phone (316)-275-9230

Contractor: License # 8241
Name Emphasis Oil Operations

Wellsite Geologist Scott Corsair
Phone (913)-398-2270

Designate Type of Completion

New Well Re-Entry Workover
 Oil SWD Temp Abd
 Gas Inj Delayed Comp. CO₂
 Dry Other (Core, Water Supply etc.)

If **OWO**: old well info as follows:

Operator Hellar Drilling
Well Name Ford #1
Comp. Date 12-29-61 Old Total Depth 4474'

WELL HISTORY

Drilling Method:

Mud Rotary Air Rotary Cable

8/24/88 8/26/88 9-30-88
Spud Date Date Reached TD Completion Date
4476' 4440'
Total Depth PBDT

Amount of Surface Pipe Set and Cemented at 325 feet prev
Multiple Stage Cementing Collar Used? Yes No
If yes, show depth set 1497' feet
If alternate 2 completion, cement circulated from 1497' feet depth to surf 405' SX cmt
Cement Company Name Halliburton
Invoice # 620499

API NO. 15-135-01-0007

County Ness

C. NE. NW Sec. 26 Twp. 19S Rge. 22 East
 West

4620 Ft North from Southeast Corner of Section
3300 Ft West from Southeast Corner of Section

(Note: Locate well in section plat below)


Lease Name Dorsa "OWO" Well # 1

Field Name

Producing Formation Mississippian & Cherokee

Elevation: Ground 2255' KB 2260'

Section Plat

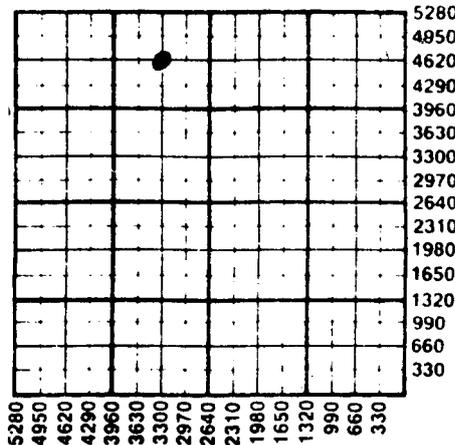

WATER SUPPLY INFORMATION

Disposition of Produced Water: Disposal
Docket # Repressuring

Questions on this portion of the ACO-1 call:

Water Resources Board (913) 296-3717

Source of Water:
Division of Water Resources Permit # NA

Groundwater.....Ft North from Southeast Corner
(Well)Ft West from Southeast Corner of
set Sec Twp Rge East West

Surface Water.....Ft North from Southeast Corner
(Stream, pond etc).....Ft West from Southeast Corner
Sec Twp Rge East West

Other (explain) Larry Kieweno farm pond
(purchased from city, R.W.D. #)

INSTRUCTIONS: This form shall be completed in triplicate and filed with the Kansas Corporation Commission, 200 Colorado Derby Building, Wichita, Kansas 67202, within 120 days of the spud date of any well. Rule 82-3-130, 82-3-107 and 82-3-106 apply. Information on side two of this form will be held confidential for a period of 12 months if requested in writing and submitted with the form. See rule 82-3-107 for confidentiality in excess of 12 months. One copy of all wireline logs and drillers time log shall be attached with this form. Submit CP-4 form with all plugged wells. Submit CP-111 form with all temporarily abandoned wells.

All requirements of the statutes, rules and regulations promulgated to regulate the oil and gas industry have been fully complied with and the statements herein are complete and correct to the best of my knowledge.

Signature Scott Corsair

Title Geologist Date 12-5-88

Subscribed and sworn to before me this 5th day of December 1988

Notary Public Larry D. Stieben

Notary Commission Expires 1-3-92

K.C.C. OFFICE USE ONLY
 Letter of Confidentiality Attached
 Wireline Log Received
 Drillers Timelog Received
Distribution
 KCC SWD/Rep NGPA
 KGS Plug Other (Specify)

Larry D. Stieben
NOTARY PUBLIC
State of Kansas
MY APPT. EXPIRES 1-3-92

Sec 26 Twp 19 Rge 22