SIDE ONE

S

STATE CORPORATION COMMISSION OF KANSAS
OIL & GAS CONSERVATION DIVISION
WELL COMPLETION OR RECOMPLETION FORM
ACO-1 WELL HISTORY
DESCRIPTION OF WELL AND LEASE

API NO. 15- 135-23-289

County: Ness

C SW SE Sec. 22 Twp. 19S Rge. 22 East X West

660 Ft North from Southeast Corner of Section
1980 Ft West from Southeast Corner of Section
(Note: Locate well in section plat below)

Lease Name: Rahm Well #: 1

Field Name:

Producing Formation: Mississippi

Elevation: Ground: 2235 KB: 2240

Operator: License #: 3536
Name: RAMCO Drilling Services, Inc.
Address: 127 Lee Street
P. O. Box 99
City/State/Zip: Belpre, OH 45714

Purchaser:

Operator Contact Person: Jack L. Partridge
Phone: (316) 262-1841

Contractor: License #: 5422
Name: Abercrombie Drilling, Inc.

Wellsite Geologist: Robert W. Smith
Phone: (316) 564-3362

Designate Type of Completion
X New Well ___ Re-Entry ___ Workover
___ Oil ___ SWD ___ Temp. Abd.
___ Gas ___ Inj X Delayed Comp.
___ Dry ___ Other (Core, Water Supply etc.)

If OWWO: old well info as follows:
Operator:
Well Name:
Comp. Date: Old Total Depth:

RECEIVED
STATE CORPORATION COMMISSION
NOV 21 1988
CONSERVATION DIVISION
Wichita, Kansas

Section Plat

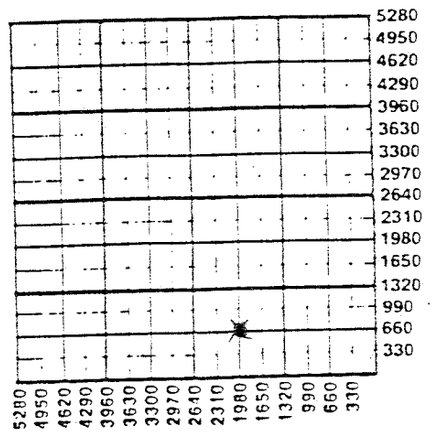

WATER SUPPLY INFORMATION
Disposition of Produced Water: ___ Disposal
Docket #: ___ Repressuring

Questions on this portion of the ACO-1 call:
Water Resources Board (913) 296-3717
Source of Water:
Division of Water Resources Permit #:

___ Groundwater: Ft North from Southeast Corner
(Well) Ft West from Southeast Corner of
Sec Twp Rge ___ East ___ West

___ Surface Water: Ft North from Southeast Corner
(Stream, pond etc.): Ft West from Southeast Corner
Sec Twp Rge ___ East ___ West

X Other (explain): Alex Dechant
(purchased from city, R.W.D. #)

WELL HISTORY
Drilling Method:
X Mud Rotary ___ Air Rotary ___ Cable

Spud Date	Date Reached TD	Completion Date
9-21-88	9-30-88	

Total Depth	PBTD
4470'	4418'

Amount of Surface Pipe Set and Cemented at 371 feet
Multiple Stage Cementing Collar Used? ___ Yes X No
If yes, show depth set: feet
If alternate 2 completion, cement circulated
from: feet depth to: w/ SX cmt
Cement Company Name:
Invoice #:

INSTRUCTIONS: This form shall be completed in triplicate and filed with the Kansas Corporation Commission, 200 Colorado Derby Building, Wichita, Kansas 67202, within 120 days of the spud date of any well. Rule 82-3-130, 82-3-107 and 82-3-106 apply.
Information on side two of this form will be held confidential for a period of 12 months if requested in writing and submitted with the form. See rule 82-3-107 for confidentiality in excess of 12 months.
One copy of all wireline logs and drillers time log shall be attached with this form. Submit CP-4 form with all plugged wells. Submit CP-111 form with all temporarily abandoned wells.

All requirements of the statutes, rules and regulations promulgated to regulate the oil and gas industry have been fully complied with and the statements herein are complete and correct to the best of my knowledge.

Signature:
Title: Date: 11-17-88

NOV 22 1988
KANSAS GEOLOGICAL SURVEY
WICHITA BRANCH

Subscribed and sworn to before me this 17th day of November, 1988.
Notary Public: James E. Blair
Date Commission Expires: James E. Blair, Notary Public
State of West Virginia
My Commission Expires April 7, 1994

K.C.C. OFFICE USE ONLY
F ✓ Letter of Confidentiality Attached
C ✓ Wireline Log Received
C ___ Drillers Timelog Received
Distribution
___ KCC ___ SWD/Rep ___ NGPA
✓ KGS ___ Plug ___ Other (Specify)

Sec. 22 Twp. 19 Rge. 22 W

Form ACO-1 (5-86)