


25-19-22W

WELL LOG BUREAU—KANSAS GEOLOGICAL SOCIETY
508 East Murdock, Wichita, Kansas

Company- SINCLAIR OIL & GAS CO.
Farm- Dora Wagner No. 2

SEC. 25 T. 19 R. 22W
C NW SW

Total Depth. 4405'
Comm. 2-28-64 Comp. 3-15-64
Shot or Treated.
Contractor. Gabbert-Jones Inc.
Issued. 6-13-64

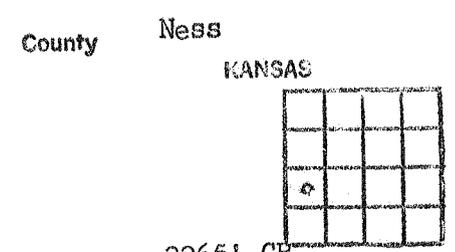

CASING:
8 5/8" 1483' cem w/700 sx.
5 1/2" 4404' cem w/150 sx.

Elevation. 2265' GR

Production. TEMP. ABDN.

Figures Indicate Bottom of Formations.

clay, sand & shale	275
shale & red rock	580
shale, shells & redbed	730
shale, sand & redbed	1215
shale & shells	1435
redbed	1460
Anhydrite	1590
sdv shale	1710
shale	2130
shale & lime	2467
lime	3600
lime & shale	2680
lime	2900
lime & shale	3275
shale	3425
shale & lime	2816
lime	4405
Total Depth	

TOPS: LOG	
Anhydrite (sample)	1463
Heebner	3732
Lansing Kansas City	3780
Ft. Scott	4288
Cherokee	4311
Mississippi	4378